Number: 202400012902

Recorded: 4/19/2024 at 10:58:21.0 AM

County Recording Fee: \$7.00 lowa E-Filing Fee: \$3.00 Combined Fee: \$10.00

Revenue Tax:

Sandie L. Smith, RECORDER Black Hawk County, Iowa

Prepared by & Return to: Isaiah M. Reicks, HRS, LLC, 2206 East Bremer Avenue, Waverly, IA 50677, Phone 319-483-5187

United States Public Land Survey Corner Certificate

Land Survey Monument situated in
Section **8**, Township **88** North, Range **14** West of the Fifth Principal Meridian, **Black Hawk** County, Iowa.
Not on file in the County Recorder's Office.

This certificate is being prepared in compliance with Iowa Code Chapter 355.11 because:

■ Inhere is no certificate on file for this corner.
 □ There are no longer three valid ties of record.
 □ There are changes to reference ties of record.
 □ There is change of monumentation of record.
 ■ □ To clarify description of record monument (ties).


Monument Description and Remarks:

Center of Section:

Found Limestone (7" \times 12") with information obtained from a Historical Survey By John Ball, Page 634 on file the County Engineer's Office. Placed Cut "X" at the High Point to perpetuate this corner.

Plan View - Not to Scale

(Show a minimum of three reference ties to durable physical objects, relevant monuments and physical conditions that will enable recovery of the corner.)

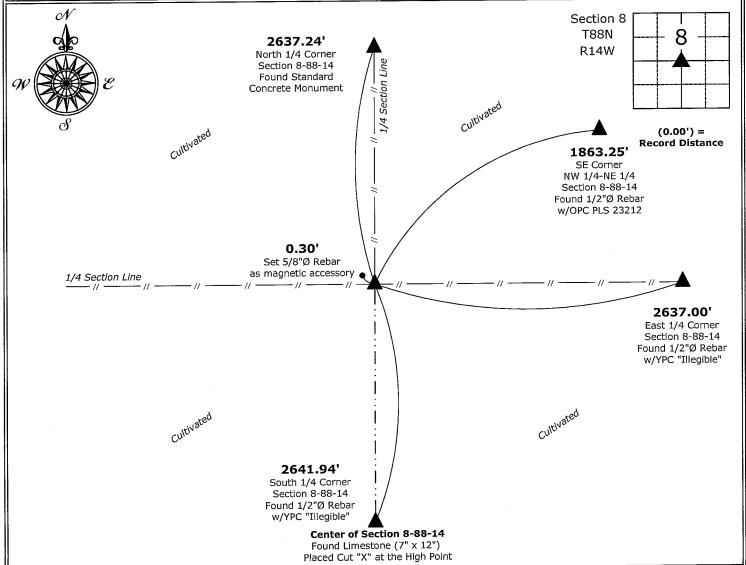



I hereby certify that this land surveying document was prepared and the related survey work was performed by me or under my direct personal supervision and that I am a duly licensed Land Surveyor under the laws of the State of Iowa.

Isaiah M. Reicks Date:

License number 22468

My license renewal date is December 31, 2025. Sheets covered by this seal: Individual sheet only

List Corner to be Indexed			
Corner	Section	Township	Range
CTR	8	88	14

Project Number: 2024-522 FB: Black Hawk, Page(s) 27-30 :__Projects - WO\County Control Systems_WO\BLACK HAWK\BHCO-20\BHCO-20-2024.dwg, 4/19/2024 7:50:26 AM