Number: 202400012903

Recorded: 4/19/2024 at 10:58:21.0 AM

County Recording Fee: \$7.00 Iowa E-Filing Fee: \$3.00 Combined Fee: \$10.00

Revenue Tax:

Sandie L. Smith, RECORDER Black Hawk County, Iowa

ah M. Reicks, HRS, LLC, 2206 East Bremer Avenue, Waverly, IA 50677, Phone 319-483-5187

United States Public Land Survey Corner Certificate

Land Survey Monument situated in

Section 8, Township 88 North, Range 14 West of the Fifth Principal Meridian, Black Hawk County, Iowa. On file in Book 337, Page 154 in the County Recorder's Office.

This certificate is being prepared in compliance with Iowa Code Chapter 355.11 because:

There is no certificate on file for this corner. There are no longer three valid ties of record. There are changes to reference ties of record. There is change of monumentation of record. □ To clarify description of record monument (ties).


Monument Description and Remarks:

Northeast Corner:

The previously recorded Section Corner Certificate, indicates "Found Bolt". Recovered said Bolt, found unstable. Removed and excavated further and found a bent 3/4"Ø Rebar. Removed and excavated further and found Standard Concrete Monument (24" Deep). Set 5/8"Ø Rebar w/2"Ø Aluminum Cap PLS 22468 above said Standard Concrete Monument to perpetuate this Corner.

Plan View - Not to Scale

(Show a minimum of three reference ties to durable physical objects, relevant monuments and physical conditions that will enable recovery of the corner.)

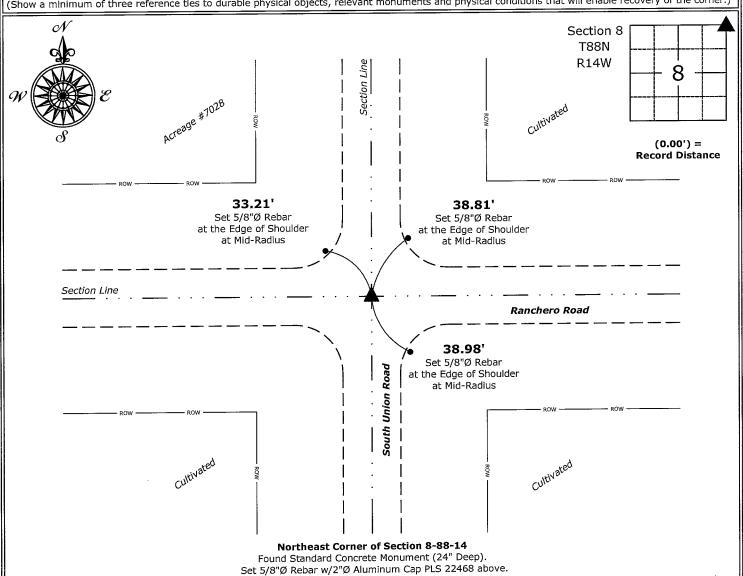

REICKS

I hereby certify that this land surveying document was prepared and the related survey work was performed by me or under my direct personal supervision and that I am a duly licensed Land Surveyor under the laws of the State of Iowa.

19-24 1 Isaiah M. Reicks Date:

License number 22468

My license renewal date is December 31, 2025. Sheets covered by this seal: Individual sheet only

List Corner to be Indexed			
Corner	Section	Township	Range
NE	8	88	14

Project Number: 2024-522 FB: Black Hawk 11, Page(s) 27-30 Projects - WO\County Control Systems_WO\BLACK HAWK\BHCO-20\BHCO-20-2024.dwg, 4/19/2024 7:49:50 AM