

UNITED STATES PUBLIC LAND SURVEY CORNER CERTIFICATE

Land Survey Monuments situated in Section 9, Township 88 North, Range 14 West, of the Fifth Principal Meridian, Black Hawk County, Iowa.

Previously recorded in N/A in County Recorder's Office.


(Show reason for preparing this certificate, the evidence and detailed procedures used in establishing the corner positions and monumentation found or placed.)

Monument Description and Remarks: Set 1/2" rebar / cap #9018. Obtained dist. from SW cor. to NW cor. with 1/4 cor. dist. Measured this dist. and prorated. This came on fence line East & West. Dug hole to 3' depth at the prorated distance and 2 ties to fence to East. Found nothing. County Eng. office also dug at this location and did not

PLAN - VIEW

(Show a minimum of three reference ties to durable physical objects, relevant monuments and physical conditions that will enable recovery of the corner)

find monument. After discussion with Eng. office set pin at prorated distance and two ties.

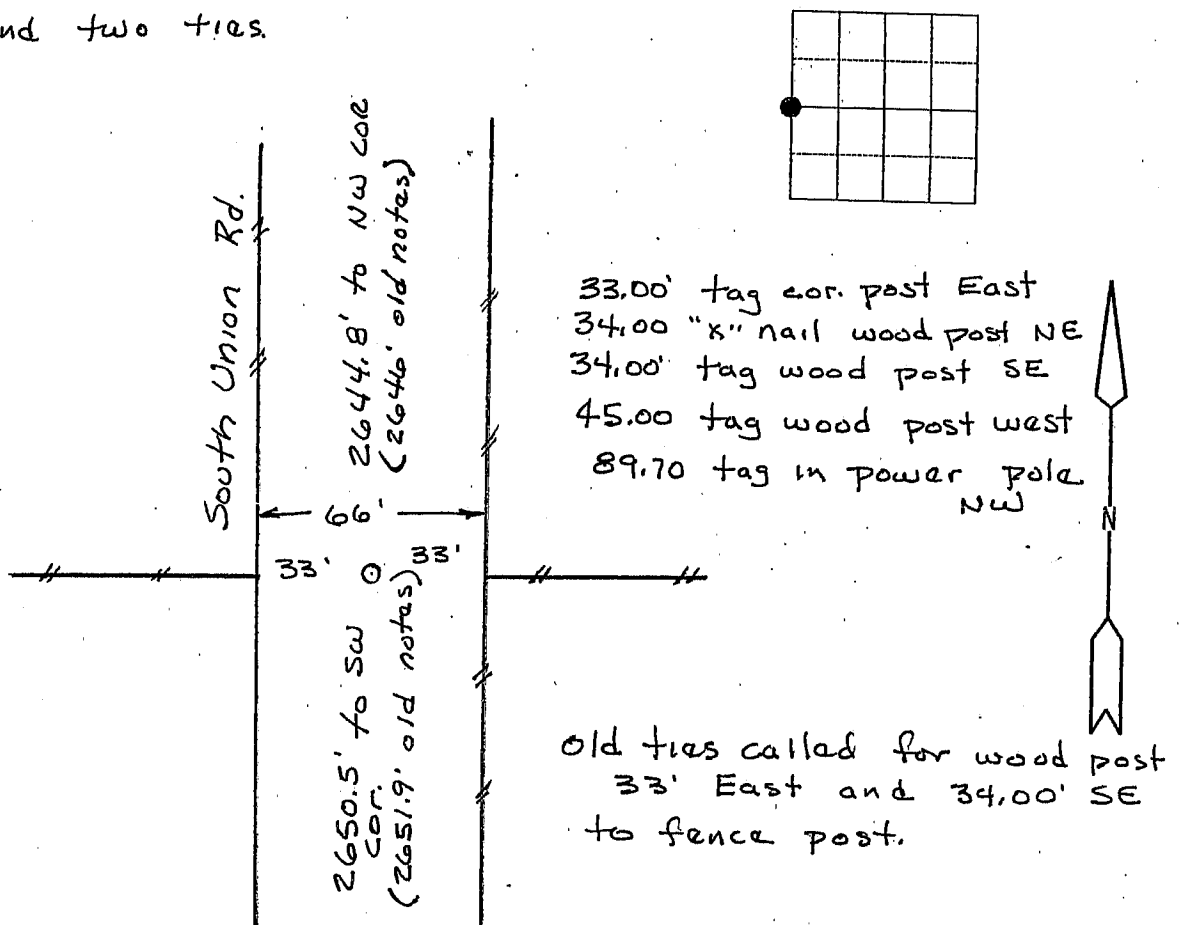


I hereby certify that the survey work was completed and this land surveying document was prepared by me or under my direct personal supervision and that I am a duly licensed land surveyor under the laws of the state of Iowa

Signature: Steve Bosse
Name typed or printed STEVE BOSSE

Date: 2/1/00 Reg. No. 9018

My license renewal date is December 31, 2000

SEAL

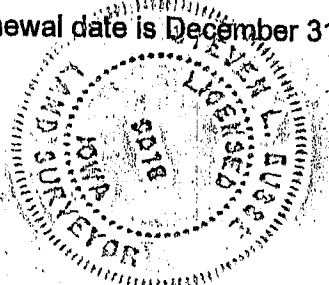

Corners	List Corners to be Indexed		
	Section	Twp	Range
West 1/4 cor.	9	88	14