
Doc ID: 007532430001 Type: GEN

Doc ID: 007532430001 Type: GEN Recorded: 01/11/2017 at 10:42:04 AM Fee Amt: \$7.00 Page 1 of 1 Black Hawk County Iowa SANDIE L. SMITH RECORDER

File 2017-00012619

WAYNE CLAASSEN ENGINEERING AND SURVEYING, INC. P.O. BOX 898 WATERLOO, IOWA 50704-0898

PHONE: (VOICE) 319-235-6294 (FAX) 319-235-0028

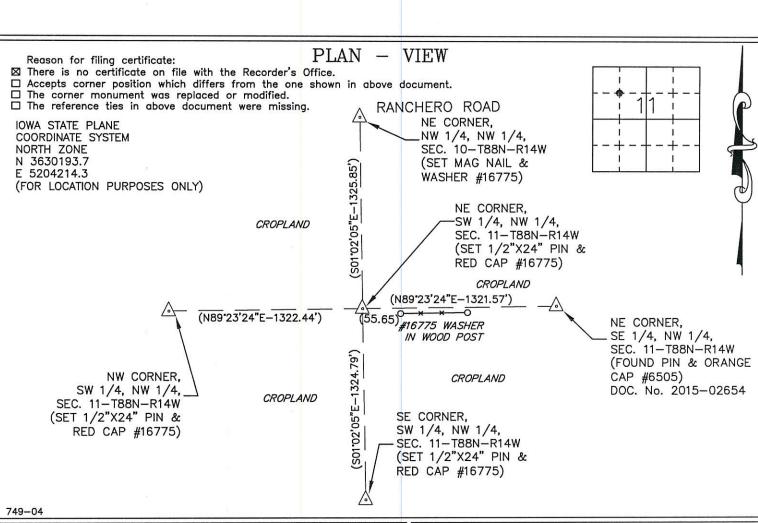

I hereby certify that this land surveying document was prepared and the related survey work was performed by me or under my direct personal supervision and that I am a duly Licensed Land Surveyor under the laws of the State of Iowa.

Signature:
David L. Scheil, L.S.

Date: 100 05, 2017 Lic. No. 16775

Pages or Sheets Covered by this Seal: THIS SHEET ONLY.

My license renewal date is December 31, 2018

SEAL

List Corners to be Indexed

Corners Section Twp Range
SE CORNER, 11 88 N 14 W
NW 1/4, NW 1/4,

