

V J ENGINEERING    1501 TECHNOLOGY PARKWAY    SUITE 100    CEDAR FALLS    IA    50613

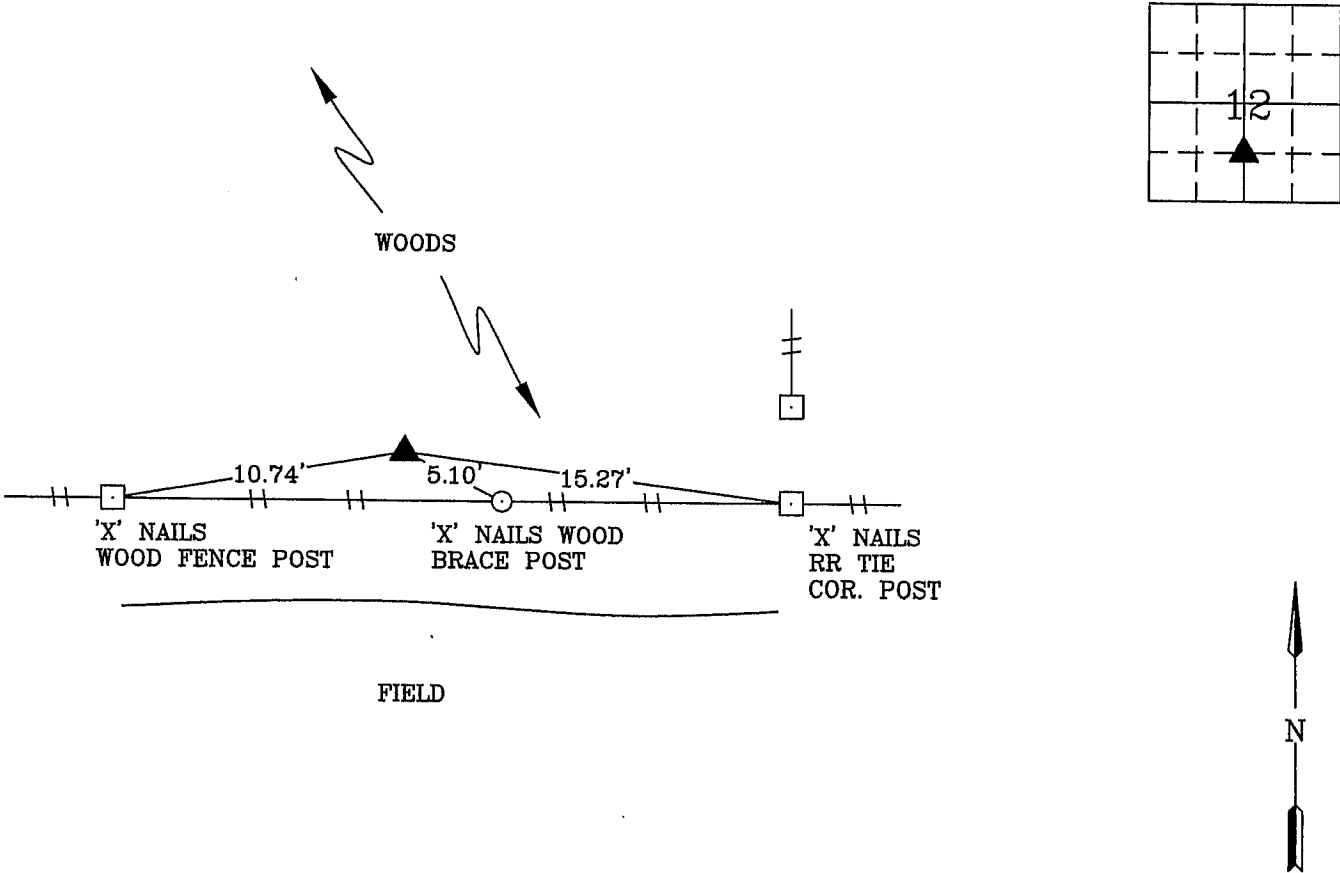
UNITED STATES PUBLIC LAND SURVEY CORNER CERTIFICATE  
OF



Land Survey Monuments situated in Section 12, Township 88 N, Range 14 W, of the Fifth Principal Meridian, BLACK HAWK County, Iowa  
Previously recorded in Book \_\_\_\_\_, Page \_\_\_\_\_.

Show reason for preparing this certificate, the evidence and detailed procedures used in establishing the corner positions and monumentation found or placed.)  
Monument Description and Remarks: NE CORNER, SE 1/4, SW 1/4, 12-88-14  
FOUND 1" PINCHED PIPE, 2" ABOVE GROUND  
NO CORNER CERTIFICATE PREVIOUSLY RECORDED

PLAN - VIEW

(Show a minimum of three reference ties to durable physical objects, relevant monuments and physical conditions recovery of the corner.)



<p>I hereby certify that the survey work was completed and this certificate was prepared by me or under my direct personal supervision and that I am a duly registered land surveyor under the laws of the state of Iowa.</p> <div><div><i>Wendell J. Lupkes 1-26-06</i> IOWA L.L.S. NO. <u>12088</u></div></div>		<p>List Corners to be Indexed</p> <table><tr><th>Corners</th><th>Section</th><th>Twp</th><th>Range</th></tr><tr><td>NE COR.</td><td>12</td><td>88</td><td>14</td></tr><tr><td>SE 1/4</td><td></td><td></td><td></td></tr><tr><td>SW 1/4</td><td></td><td></td><td></td></tr></table>	Corners	Section	Twp	Range	NE COR.	12	88	14	SE 1/4				SW 1/4			
Corners	Section	Twp	Range															
NE COR.	12	88	14															
SE 1/4																		
SW 1/4																		
<div><div>VJ Engineering 1501 Technology Parkway Cedar Falls, Iowa - 319-266-5829</div></div>	<div>SECTION CORNER REFERENCE TIES</div> <div><table><tr><td>Scale</td><td>NONE</td></tr><tr><td>drawn by</td><td>MAK</td></tr><tr><td>date</td><td>1/19/06</td></tr></table></div>	Scale	NONE	drawn by	MAK	date	1/19/06											
Scale	NONE																	
drawn by	MAK																	
date	1/19/06																	