

INDEX 18

BLACK HAWK COUNTY, IOWA:SS

FEE BOOK # 2006 18398

PROOF

FILED FOR RECORD JAN 27

2006

AT 10:00 A M.FEE 1-5.00/-1.00/

COMPARED

Wendell J. Lupkes

BLACK HAWK COUNTY RECORDER

V J ENGINEERING

1501 TECHNOLOGY PARKWAY

SUITE 100

CEDAR FALLS IA

50613

UNITED STATES PUBLIC LAND SURVEY CORNER CERTIFICATE
OF

Land Survey Monuments situated in Section 12, Township 88 N, Range 14 W, of the Fifth Principal Meridian, BLACK HAWK County, Iowa
Previously recorded in Book _____, Page _____.



Show reason for preparing this certificate, the evidence and detailed procedures used in establishing the corner positions and monumentation found or placed.)

Monument Description and Remarks: N 1/4 CORNER - FOUND 1" PINCHED PIPE, 10" DEEP

NO CORNER CERTIFICATE PREVIOUSLY RECORDED

PLAN - VIEW

(Show a minimum of three reference ties to durable physical objects, relevant monuments and physical conditions recovery of the corner.)

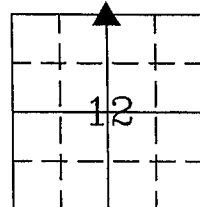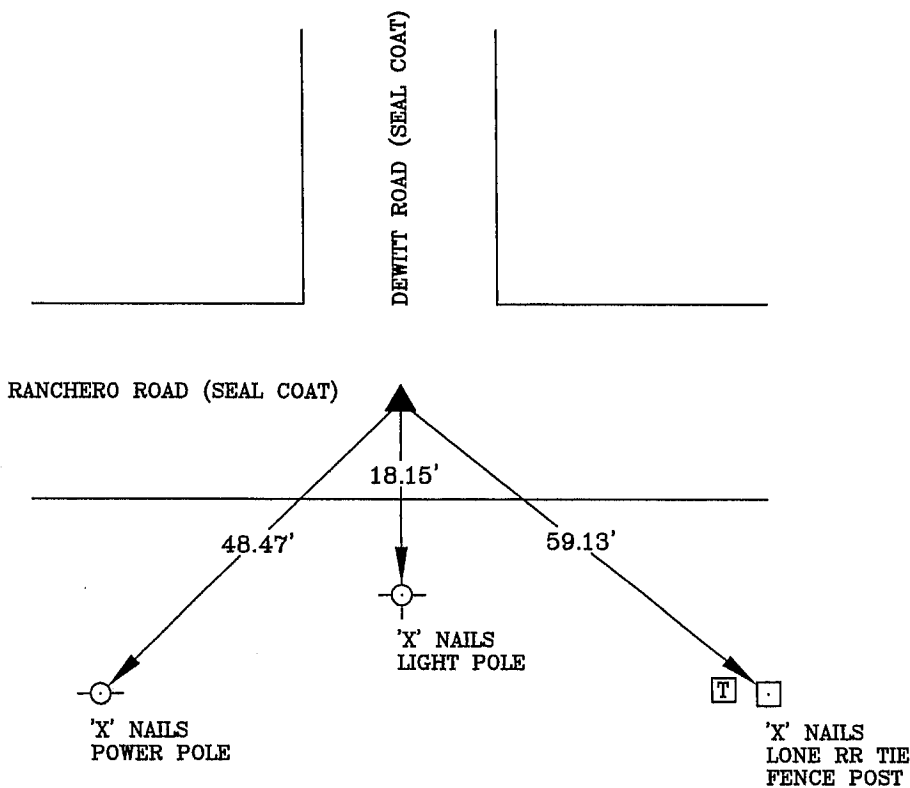

I hereby certify that the survey work was completed and this certificate was prepared by me or under my direct personal supervision and that I am a duly registered land surveyor under the laws of the state of Iowa.



Wendell J. Lupkes 1-26-06
IOWA L.L.S. NO. 12088

List Corners to be Indexed

Corners	Section	Twp	Range
N 1/4	12	88	14



VJ Engineering
1501 Technology Parkway
Cedar Falls, Iowa - 319-266-5829

SECTION CORNER
REFERENCE TIES

Scale
NONE
drawn by
MAK
date
1/19/06