

Recorded

UNITED STATES PUBLIC LAND SURVEY CORNER CERTIFICATE

SLSI 9-90

OF


Previously recorded in MISC. 293-995 in County Recorder's Office.
(book, page, document number, etc.)

(Show reason for preparing this certificate, the evidence and detailed procedures used in establishing the corner positions and monumentation found or placed.)

Monument Description and Remarks: TOP OF MONUMENT HAS BEEN BROKEN OFF
SINCE CERTIFICATE OF 293-995. SET P.K. NAIL IN CENTER OF BROKEN
MONUMENT.

PLAN - VIEW

(Show a minimum of three reference ties to durable physical objects, relevant monuments and physical conditions that will enable recovery of the corner.)

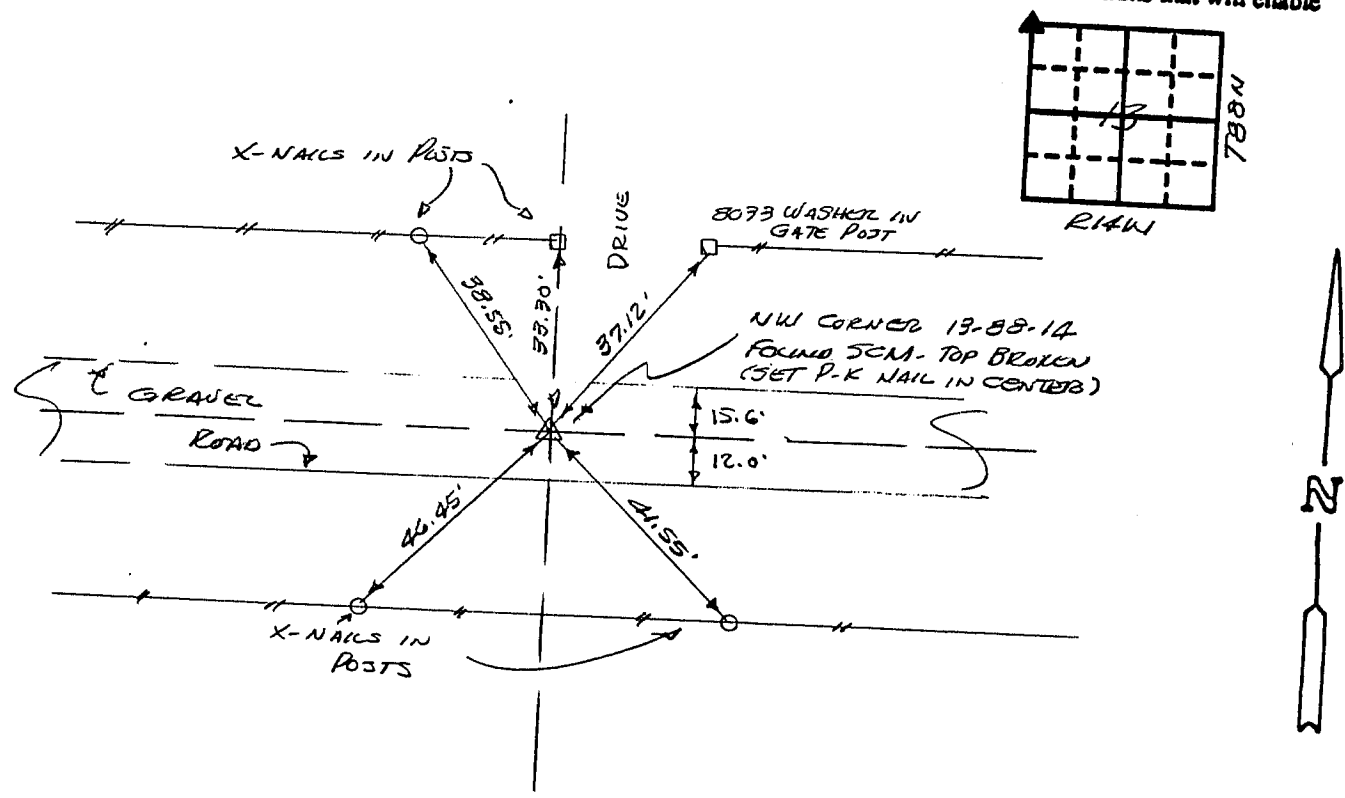


I hereby certify that the survey work was completed and this certificate was prepared by me or under my direct personal supervision and that I am a duly registered land surveyor under the laws of the state of Iowa.

Signature: F. William King
Name typed or printed: F. WILLIAM KING
Date: 1-7-1992 Reg. No. 8033

Corners	List Corners to be Indexed	Section	Twp	Range

SEAL

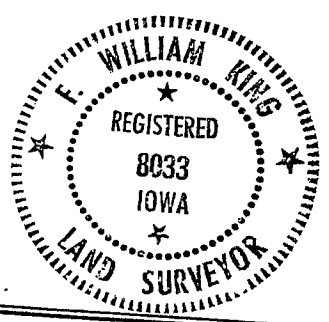

MISC. BK. 299 p. 418