

UNITED STATES PUBLIC LAND SURVEY CORNER CERTIFICATE

SLSI 9-90


OF

Land Survey Monuments situated in Section 13, Township 88N, Range 14W, of the Fifth Principal Meridian, BLACK HAWK County, Iowa.
Previously recorded in N/A in County Recorder's Office.
(Show reason for preparing this certificate, the evidence and detailed procedures used in establishing the corner positions and monument found or placed.)

Monument Description and Remarks: FOUND 11"x8" LIMESTONE, JCM GONE. 1960 DOT
TIES USED TO LOCATE STONE, WPA NOTES OF 10-5-1938 CALLED FOR 8"x9"x10"
LIMESTONE ORIGINAL STONE UNDER JCM. STONE FOUND 2.8' DEEP, SET 1/2" REPAIR
W/ 8033 CAP OVER CENTER @ 2" DEEP. SET 3/4" OPEN PIPE ON NORTH EDGE OF STONE
1" BELOW TOP OF STONE.

PLAN - VIEW


(Show a minimum of three reference ties to durable physical objects, relevant monuments and physical conditions that will enable recovery of the corner.)

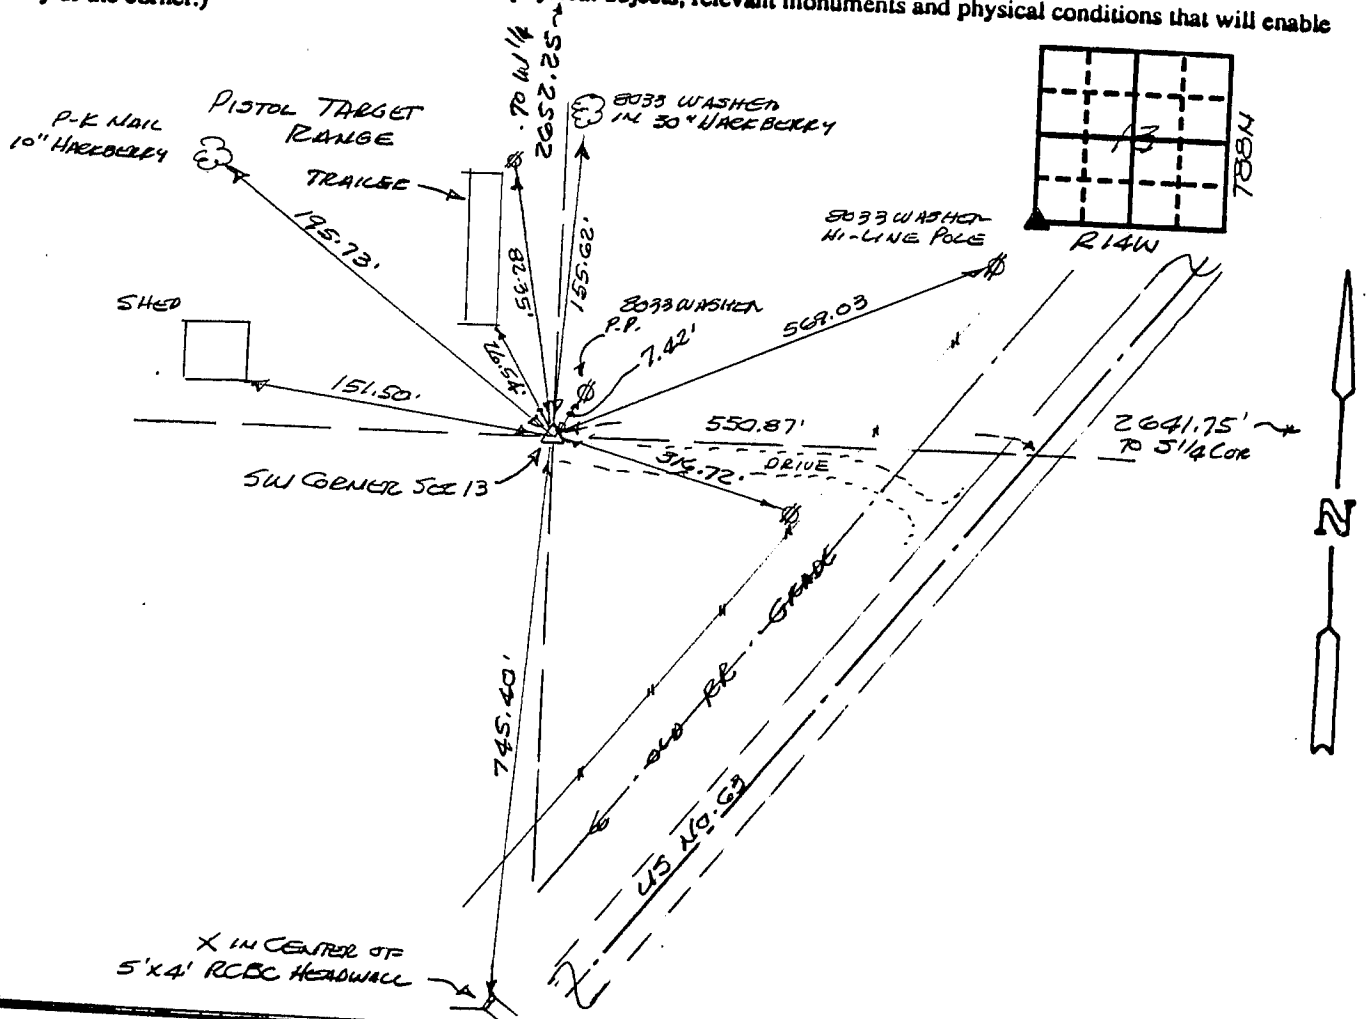

I hereby certify that the survey work was completed and this certificate was prepared by me or under my direct personal supervision and that I am a duly registered land surveyor under the laws of the state of Iowa.

Signature: F. William King
Name typed or printed: F. WILLIAM KING
Date: 1-7-1992 Reg. No. 8033

Corners	List Corners to be Indexed	Section	Twp	Range
SW	13	88N	14W	

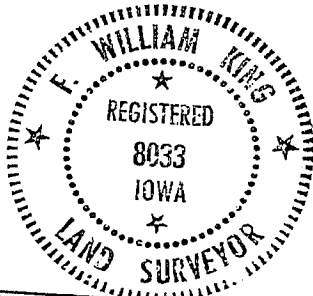

MISC. BK. 299 p. 420