

UNITED STATES PUBLIC LAND SURVEY CORNER CERTIFICATE

SLSI 9-90

OF


Land Survey Monuments situated in Section 13, Township 88N, Range 14W, of the Fifth Principal Meridian, BLACK HAWK County, Iowa.
Previously recorded in N/A in County Recorder's Office.

(Show reason for preparing this certificate, the evidence and detailed procedures used in establishing the corner positions and monumentation found or placed.)

Monument Description and Remarks: FOUND BASE OF SCM (5"x5"x15") 30" DEEP.
SET 1"Ø SOLID PIN ON NORTH EDGE OF MONUMENT @ 32" DEEP. SET 1"Ø PIPE W/8033
CAP OVER TOP CENTER OF MONUMENT - TOP OF PIPE 8" DEEP.

PLAN - VIEW

(Show a minimum of three reference ties to durable physical objects, relevant monuments and physical conditions that will enable recovery of the corner.)

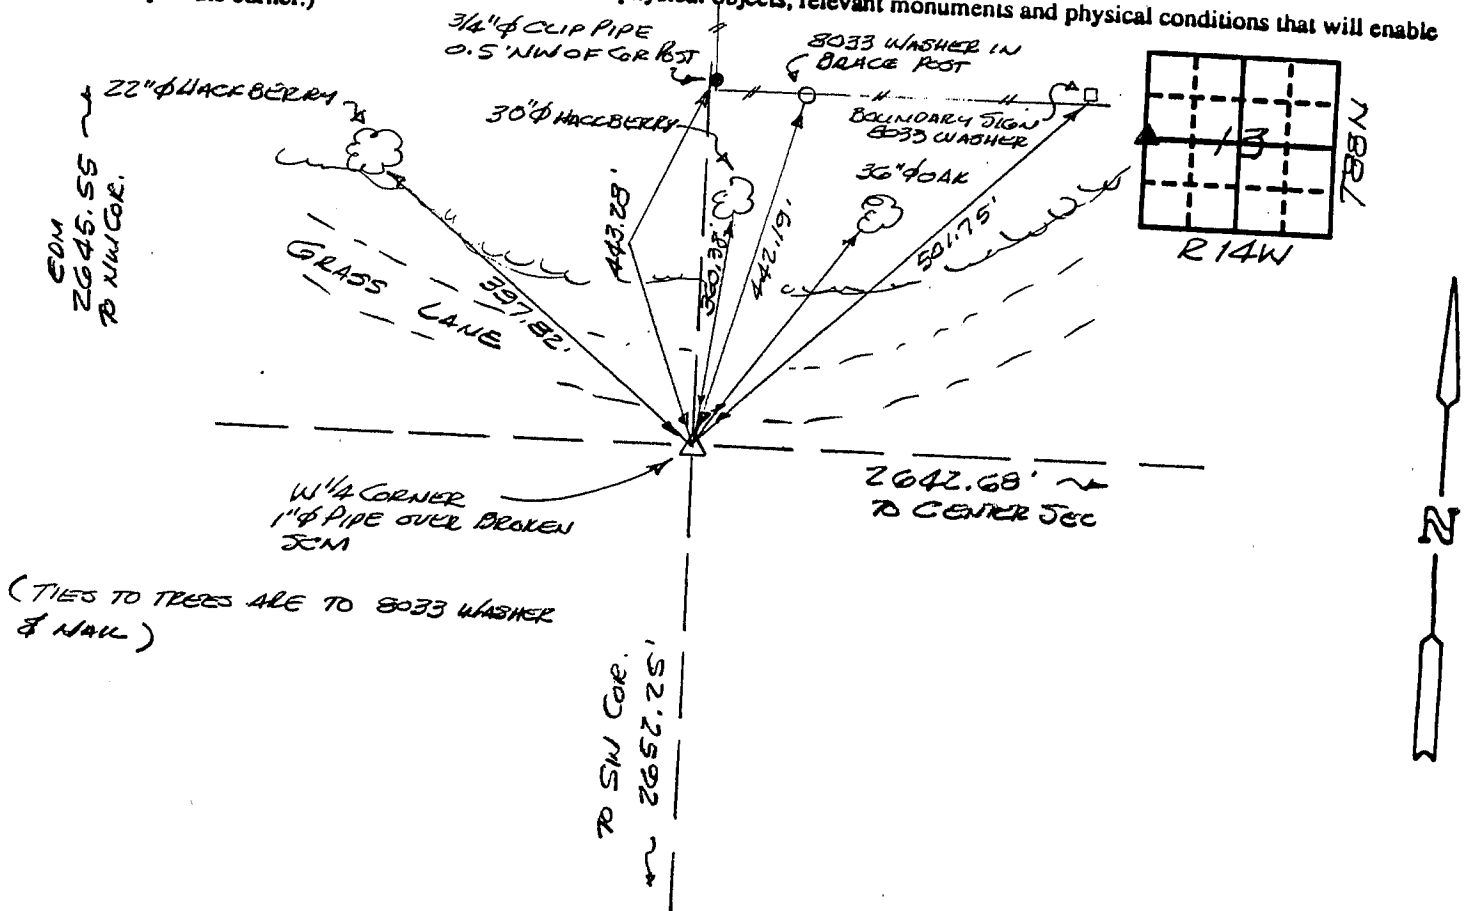


I hereby certify that the survey work was completed and this certificate was prepared by me or under my direct personal supervision and that I am a duly registered land surveyor under the laws of the state of Iowa.

Signature: F. William King
Name typed or printed: F. WILLIAM KING
Date: 1-7-1992 Reg. No. 8033

Corners	List Corners to be Indexed	Section	Twp	Range
W 1/4	13	88N	14W	

SEAL

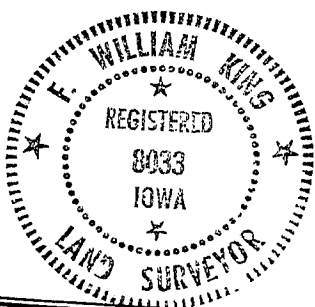

MISC. Book 299 p. 422