


UNITED STATES PUBLIC LAND SURVEY CORNER CERTIFICATE  
OF

Land Survey Monuments situated in Section 14, Township 88, Range 14  
of the Fifth Principal Meridian, BLACK HAWK County, Iowa.  
Previously recorded in (not applicable) in County Recorder's Office.


(Show reason for preparing this certificate, the evidence and detailed procedures used in establishing the corner positions and monumentation found or placed.)  
Monument Description and Remarks: NO CERTIFICATE ON FILE Y TO  
UPDATE TIES.

PLAN - VIEW

(Show a minimum of three reference ties to durable physical objects, relevant monuments and physical conditions that will enable recovery of the corner.)

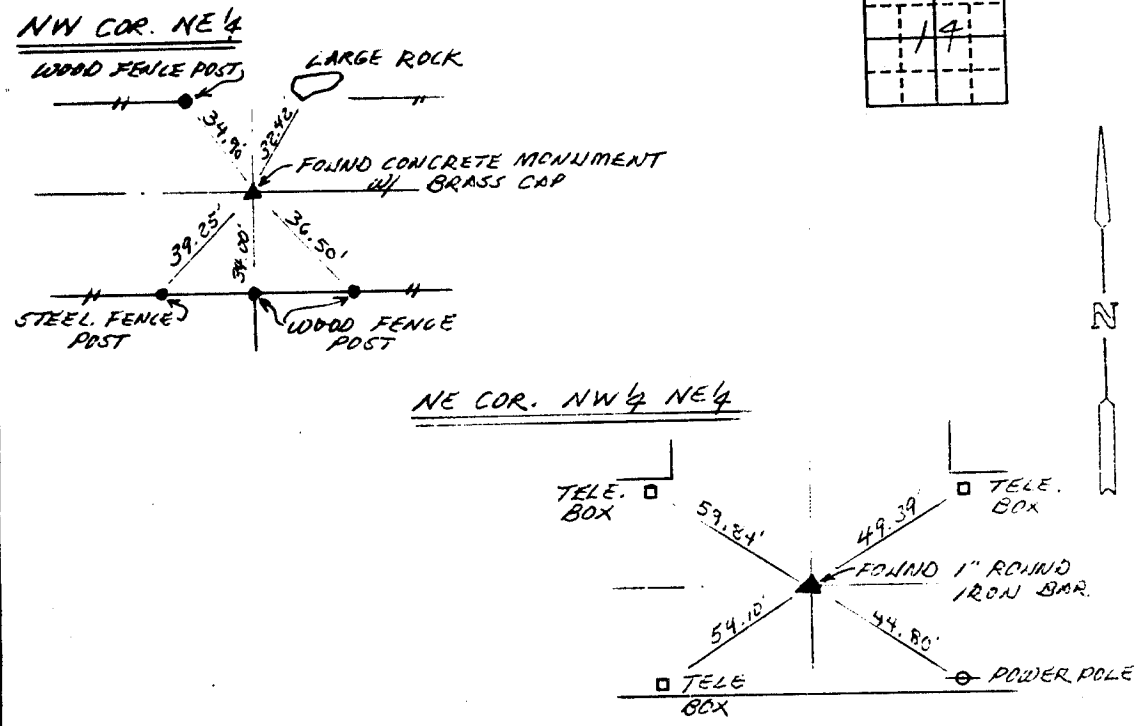

I hereby certify that the survey work was completed and this certificate was prepared by me or under my direct personal supervision and that I am a duly registered land surveyor under the laws of the state of Iowa.  
Signature: Harold F. Michels  
Name typed or printed: Harold F. Michels  
Date: April 9 1999 Reg. No. 3862

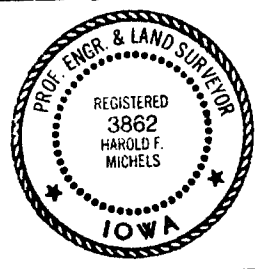

| Corners               | Section | Twp | Range |
|-----------------------|---------|-----|-------|
| NW COR. NE 1/4        | 14      | 88  | 14    |
| NE COR. NW 1/4 NE 1/4 | "       | "   | "     |