

SC
MISC
INDEX 50
MARGIN
PROOF
COMPARE

BLACK HAWK COUNTY IOWA:ss 016320
Filed for record DEC 18, 2001 at
3:30 P.M. and recorded in Book 345
of MISC at page 60.

Patricia A. Less Recorder
FEE 1-5.00/ SLSI 9-90

UNITED STATES PUBLIC LAND SURVEY CORNER CERTIFICATE
OF

WAYNE CLAASSEN ENGINEERING AND SURVEYING

Land Survey Monuments situated in Section 17, Township 88N, Range 14W, of the Fifth Principal Meridian, _____ County, Iowa.
Previously recorded in N/A in County Recorder's Office.


(book, page, document number, etc.)

(Show reason for preparing this certificate, the evidence and detailed procedures used in establishing the corner positions and monumentation found or placed.)

Monument Description and Remarks: N 1/4 COR. FOUND BASE OF CONC. MON. 2 1/2 DEEP
WITH APPROX 8" SECTION LYING FLAT ON TOP. SET "12" REBAR ON E. SIDE OF BASE
& SET "12" REBAR & CAP OVER CENTER OF DISE.

PLAN - VIEW

(Show a minimum of three reference ties to durable physical objects, relevant monuments and physical conditions that will enable recovery of the corner.)

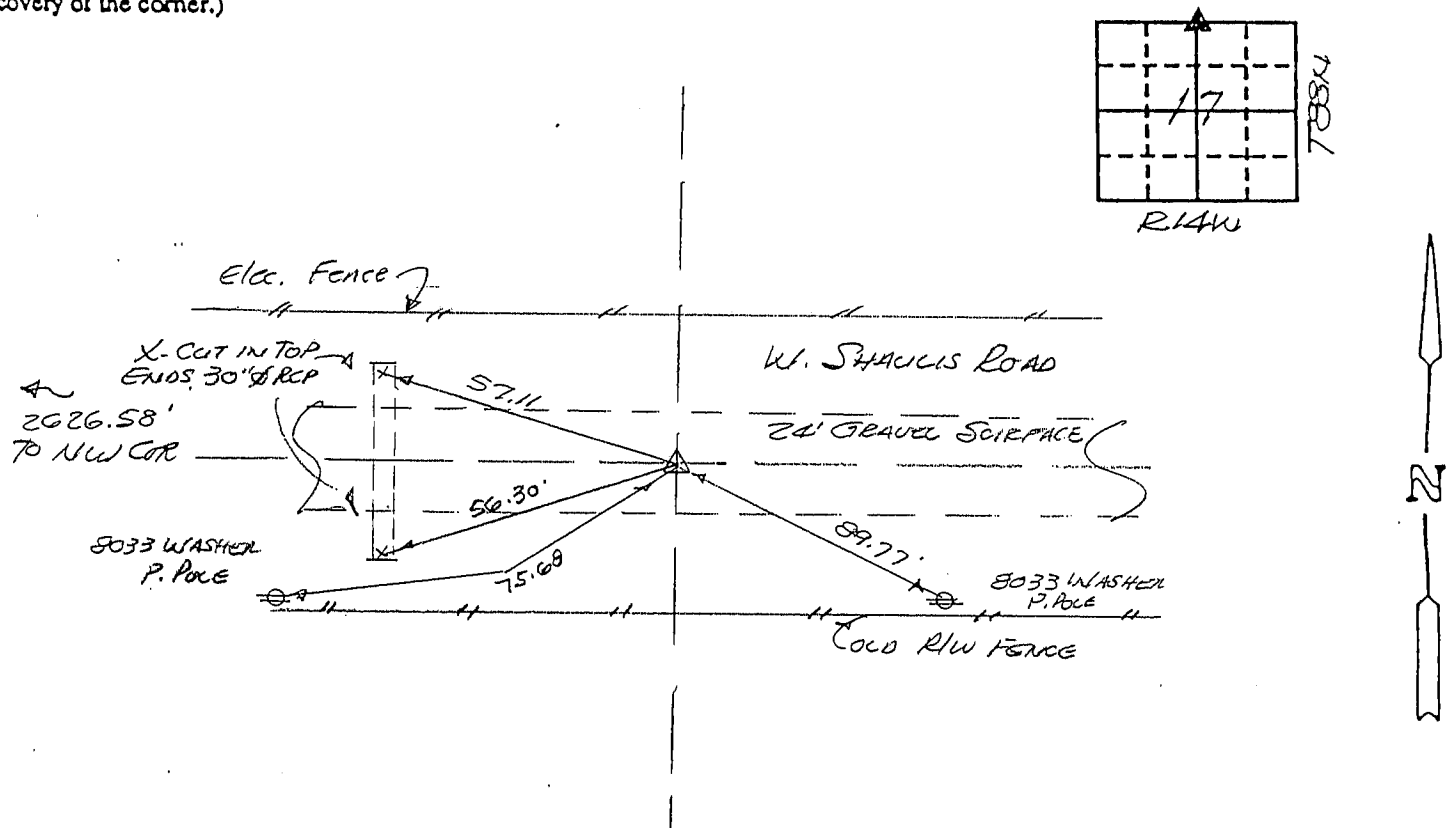

518-61

I hereby certify that the survey work was completed and this certificate was prepared by me or under my direct personal supervision and that I am a duly registered land surveyor under the laws of the state of Iowa.

Signature: *F. William King*
Name typed or printed: F. WILLIAM KING

Date: DEC. 17, 2001 Reg. No. 8033

Corners	List Corners to be Indexed	Section	Twp	Range
N 1/4	17	88N	14W	

SEAL

