

Jeffrey P. Helland, 1107 Technology Parkway, Cedar Falls, Iowa 50613-6951, (319)-266-0161

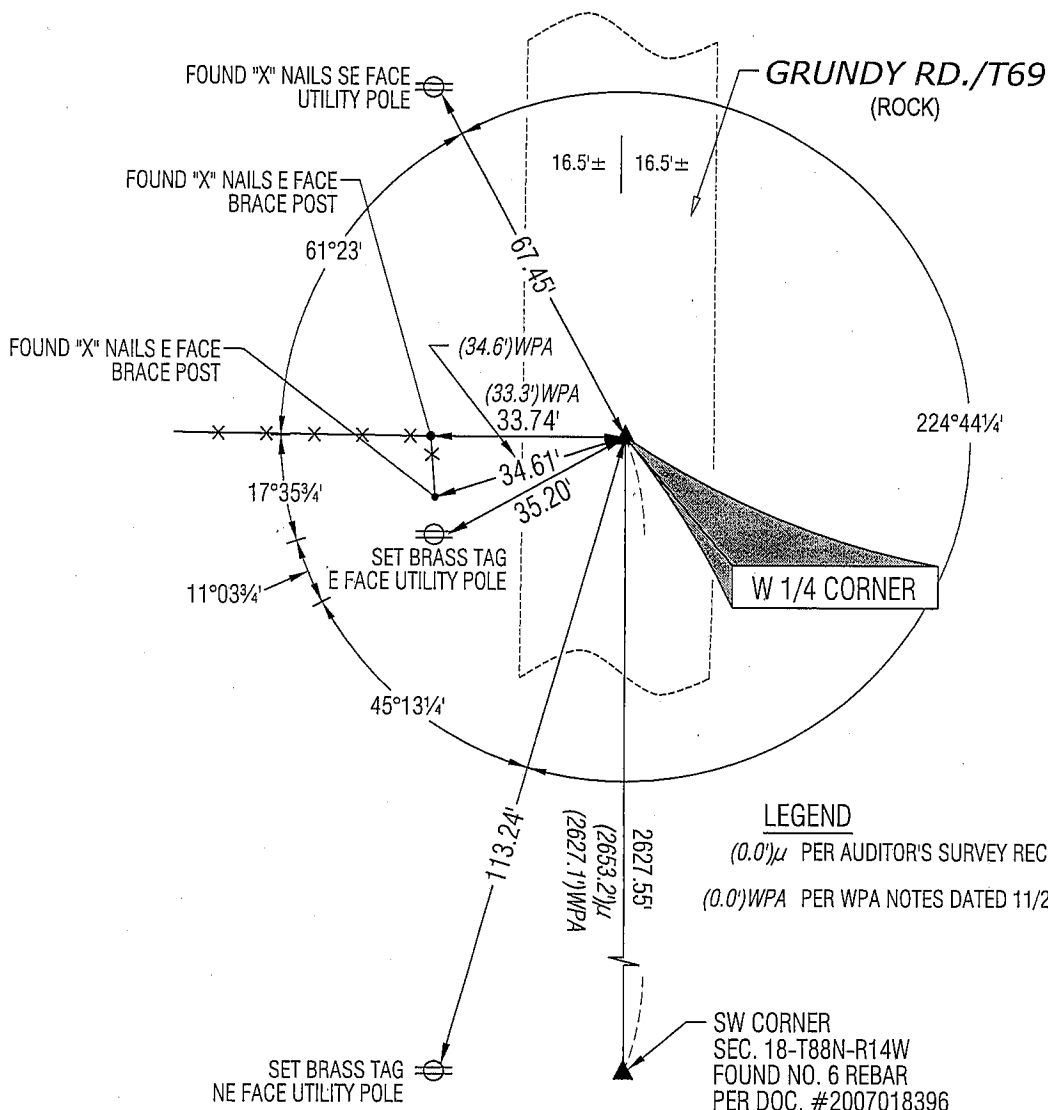
UNITED STATES PUBLIC LAND SURVEY CORNER CERTIFICATE
OFLAND SURVEY MONUMENTS SITUATED IN SECTION NO. 18, TOWNSHIP NO. 88 NORTH, RANGE
NO. 14 WEST OF THE FIFTH PRINCIPAL MERIDIAN, BLACK HAWK COUNTY, IOWA.PREVIOUSLY RECORDED IN N/A(SHOW REASON FOR PREPARING THIS CERTIFICATE, THE EVIDENCE AND DETAILED PROCEDURES USED IN ESTABLISHING THE
CORNER POSITIONS AND MONUMENTATION FOUND OR PLACED.)

MONUMENT DESCRIPTION AND REMARKS:

NO USPLSCC ON FILE. SURVEY COMPLETED IN THE W FRL 1/2 SW FRL 1/4 OF SEC. 18-T88N-R14W.

→ **W 1/4 CORNER:** BLACK HAWK COUNTY AUDITOR'S SURVEY RECORD BK 1 PG 455 DATED 5/11/1870 CALLS FOR [STONE IN MOUND]. WPA NOTES DATED 11/2/1938 CALLS FOR [FOUND NIGGERHEAD 16"x10 1/2"x7 ALSO IRON BAR 1/2"x29 1/2" AND OAK HUB 2"x3"x9". LOWERED EVIDENCE AND SET C.M. ON TOP 12" UNDERGROUND]. BLACK HAWK COUNTY ENGINEER FIELD BK 158 PG 6 CALLS FOR [STONE & IRON BAR]. FOUND STANDARD CONCRETE MONUMENT 0.15' DEEP CORRESPONDING TO REMAINING TIES. UTILIZED AS CORNER.

PLAN VIEW

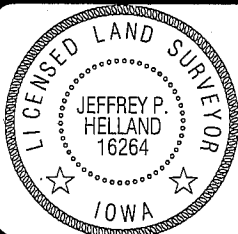
(SHOW A MINIMUM OF THREE REFERENCE TIES TO DURABLE PHYSICAL OBJECTS, RELEVANT MONUMENTS AND PHYSICAL
CONDITIONS THAT WILL ENABLE RECOVERY OF THE CORNER.)

LEGEND

(0.0')_A PER AUDITOR'S SURVEY RECORD BK 1 PG 455 DATED 5/11/1870
(0.0')_{WPA} PER WPA NOTES DATED 11/2/1938

HELLAND ENGINEERING & SURVEYING, LTD.
1107 Technology Parkway
Cedar Falls, Iowa 50613-6951
(319)-266-0161

SHINER = 8D NAIL & 1 5/16"Ø METAL SHINER
BRASS TAG = 13/16"Ø BRASS TAG
OPC = PLASTIC CAP (O=ORANGE, R=RED, Y=YELLOW)
(00') RECORDED AS FILE NAME: 08-180C1.DWG

I hereby certify that this land surveying document was prepared
and the related survey work was performed by me or under my
direct personal supervision and that I am a duly licensed Land
Surveyor under the laws of the State of Iowa.

Jeffrey P. Helland 6/5/08
Jeffrey P. Helland
License Number 16264
My license renewal date is December 31, 2009.
All pages or sheets are covered by this seal except:

LIST CORNERS TO BE INDEXED

CORNER	SECTION	TOWNSHIP	RANGE
W 1/4 CORNER	18	88N	14W