

Doc ID: 006942550001 T Recorded: 01/11/2016 at Fee Amt: \$7.00 Page 1 of Black Hawk County Iowa SANDIE L. SMITH RECORDER

File 2016-00012133

🔭 Prepared by & Return to: Herold - Reicks Surveying, 2206 East Bremer Avenue, Waverly, IA 50677, Ph. 319-483-5187

UNITED STATES PUBLIC LAND SURVEY CORNER CERTIFICATE

Land Survey Monuments situated in Section 19, Township 88 North, Range 14 West of the Fifth Principal Meridian, Black Hawk County, Iowa. 1.) Previously recorded in Document #2007-22356 in the County Recorder's office. 2.) Previously recorded in Document #2007-21311 in the County Recorder's office.

This certificate is being prepared in compliance with Iowa Code Chapter 355.11 because:


There is no certificate on file for this corner. 1 & 2 X There are no longer three valid ties of record. П There are changes to reference ties of record. X There is change of monumentation of record. To clarify description of record monument (ties).

Monument Description and Remarks:

- 1.) West 1/4 Corner: Found 5/8"Ø rebar with information obtained from the previous Section Corner Certificate, Document #2007-22356.
- 2.) Southwest Corner: Found 1/2"Ø iron pin with information obtained from the previous Section Corner Certificate, Document #2007-21311.

PLAN - VIEW

(Show a minimum of three reference ties to durable physical objects, relevant monuments and physical conditions that will enable recovery of the corner.)

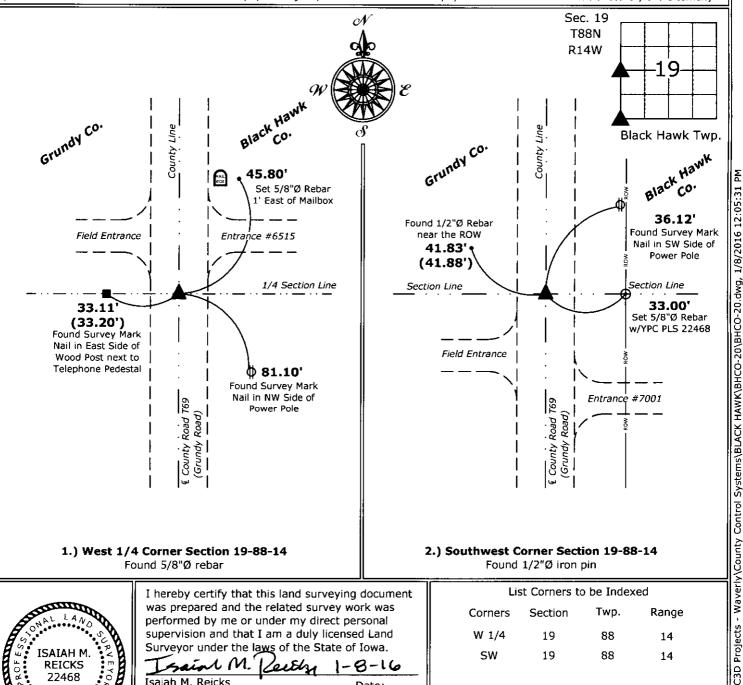



I hereby certify that this land surveying document was prepared and the related survey work was performed by me or under my direct personal supervision and that I am a duly licensed Land Surveyor under the laws of the State of Iowa.

Zevelza saint M. 1-8-16 Ísaiah M. Reicks

License number 22468

My license renewal date is December 31, 2017. Sheets covered by this seal: Individual sheet only

List Corners to be indexed			
Corners	Section	Twp.	Range
W 1/4	19	88	14
SW	19	88	14

Eila N. Project Number 28150383422 Cap FB: Black Hawk 10, Pgs. 9-10

