



Doc ID: 005667400001 Type: GEN
Recorded: 01/27/2015 at 02:12:41 PM
Fee Amt: \$7.00 Page 1 of 1
Black Hawk County Iowa
SANDIE L. SMITH RECORDER

File 2015-00012016

ENV

WAYNE CLAASSEN ENGINEERING AND SURVEYING, INC.
P.O. BOX 898 WATERLOO, IOWA 50704-0898

PHONE: (VOICE) 319-235-6294
(FAX) 319-235-0028

UNITED STATES PUBLIC LAND SURVEY CORNER CERTIFICATE

Land Survey Monuments situated in Section 26, Township 88 North, Range 14 West, of the Fifth Principal Meridian, Black Hawk County, Iowa.


Previously recorded in _____ (book, page, document number, etc.) in County Recorder's Office.

Monument Description and Remarks

Found pin & unreadable yellow cap at the Northeast corner of Tract A, Country Manor Addition, Hudson, Iowa. This certificate was filed because there is no corner certificate on file at the Black Hawk County Recorder's Office.

000.00 DENOTES RECORD DIMENSION
FROM COUNTRY MANOR ADDITION
(000.00) DENOTES FIELD DIMENSION

PLAN - VIEW

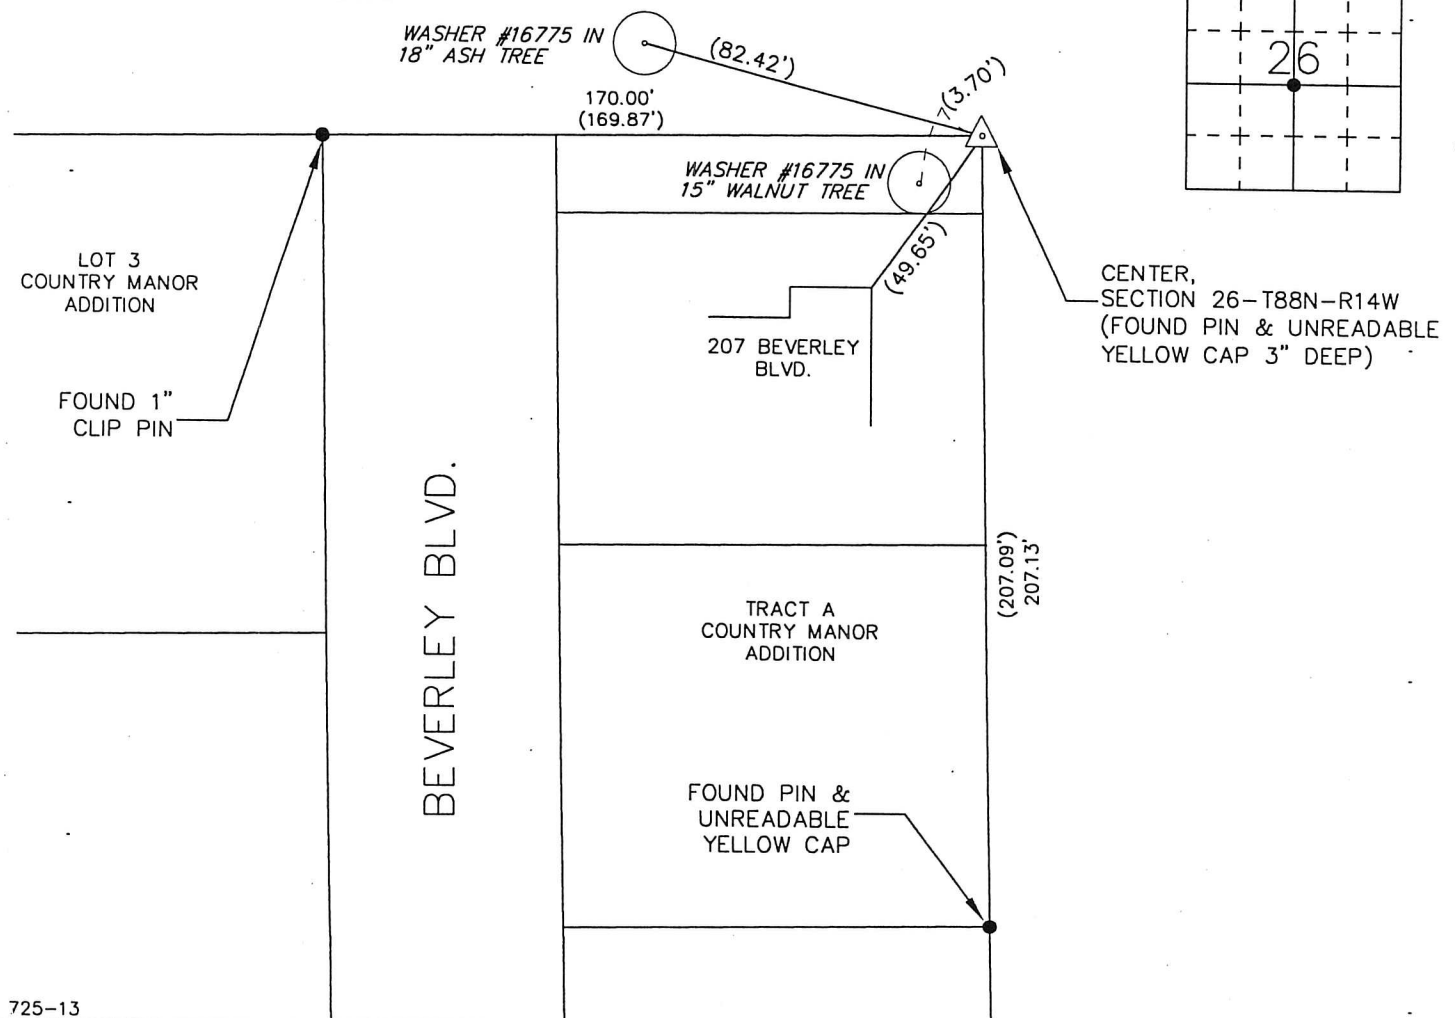

725-13

I hereby certify that this land surveying document was prepared and the related survey work was performed by me or under my direct personal supervision and that I am a duly Licensed Land Surveyor under the laws of the State of Iowa.

Signature: David L. Scheil
David L. Scheil, L.S.

Date: JAN. 23, 2015 Lic. No. 16775

Pages or Sheets Covered by this Seal: THIS SHEET ONLY.

My license renewal date is December 31, 2016

SEAL

List Corners to be Indexed

Corners	Section	Twp	Range
CENTER,	26	88 N	14 W

