

UNITED STATES PUBLIC LAND SURVEY CORNER CERTIFICATE

OF

Land Survey Monuments situated in Section 26, Township 88N, Range 14W, of the Fifth Principal Meridian, _____ County, Iowa.
Previously recorded in N/A in County Recorder's Office.


(book, page, document number, etc.)

(Show reason for preparing this certificate, the evidence and detailed procedures used in establishing the corner positions and monumentation found or placed.)

Monument Description and Remarks: FOUND 5/8" REBAR IN A-C PAVING SURFACE USING
CES TIES OF 1983. 5/8" REBAR FOUND IN 1983 PER B.H. CO. TIES.

PLAN - VIEW

(Show a minimum of three reference ties to durable physical objects, relevant monuments and physical conditions that will enable recovery of the corner.)

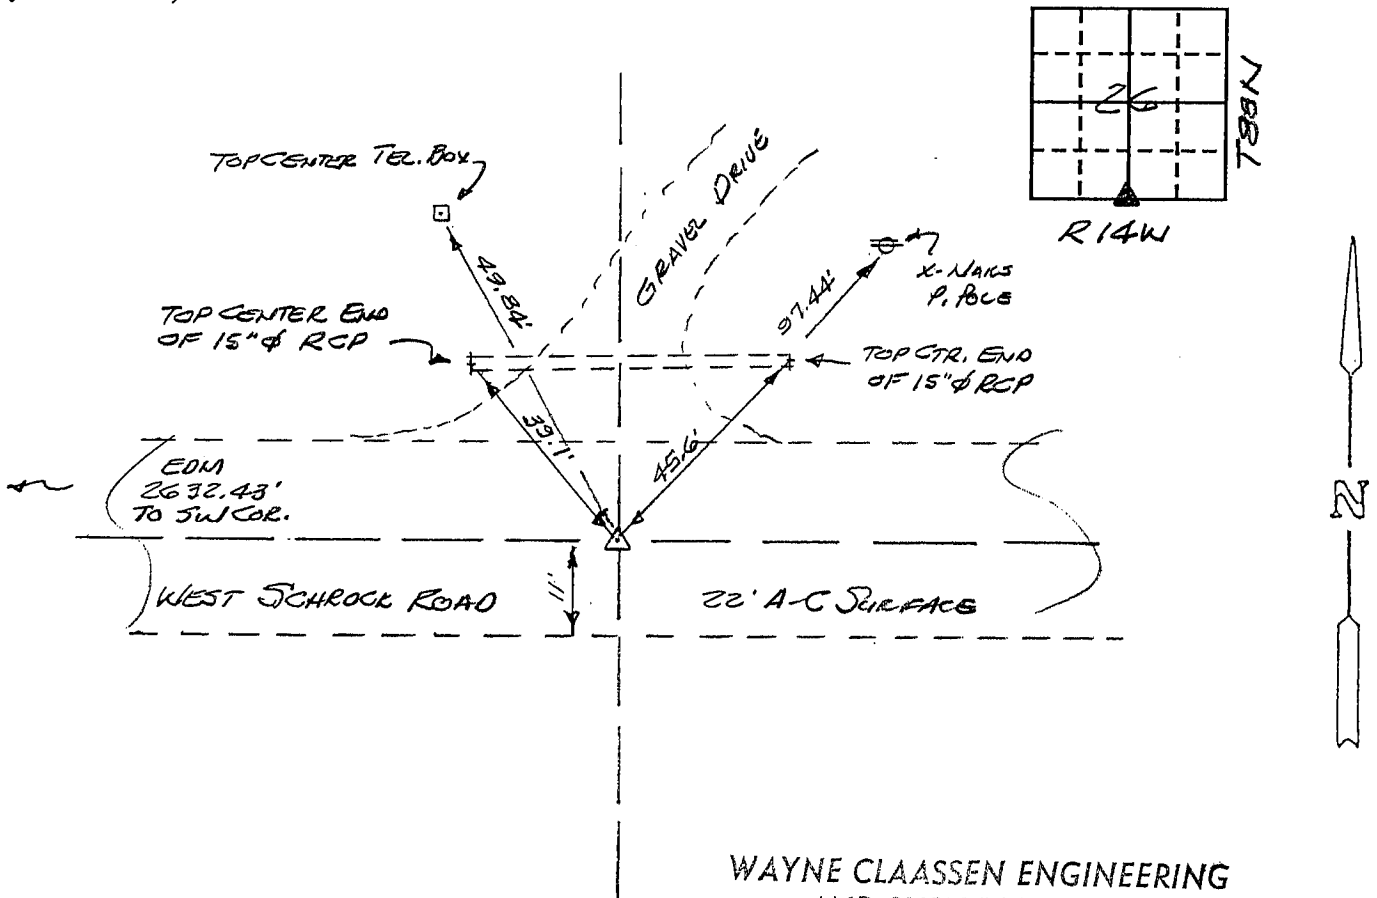

WAYNE CLAASSEN ENGINEERING
AND SURVEYING, INC.
2709 UNIVERSITY AVE.
P.O. BOX 898
WATERLOO, IA 50704

372-68

I hereby certify that the survey work was completed and this certificate was prepared by me or under my direct personal supervision and that I am a duly registered land surveyor under the laws of the state of Iowa.


Signature:

F. William King

Name typed or printed: F. WILLIAM KING

Date: 2-25-1993 Reg. No: 8033

SEAL

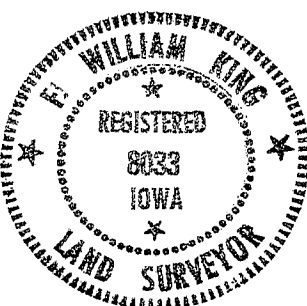

Corners	List Corners to be Indexed		
	Section	Twp	Range
S 1/4	26	88N	14W
N 1/4	35	T88N	R 14W

MISC. BK. 305 p. 276