

Paul H. Helland, 1107 Technology Parkway, Cedar Falls, Iowa 50613-6951, (319)-266-0161

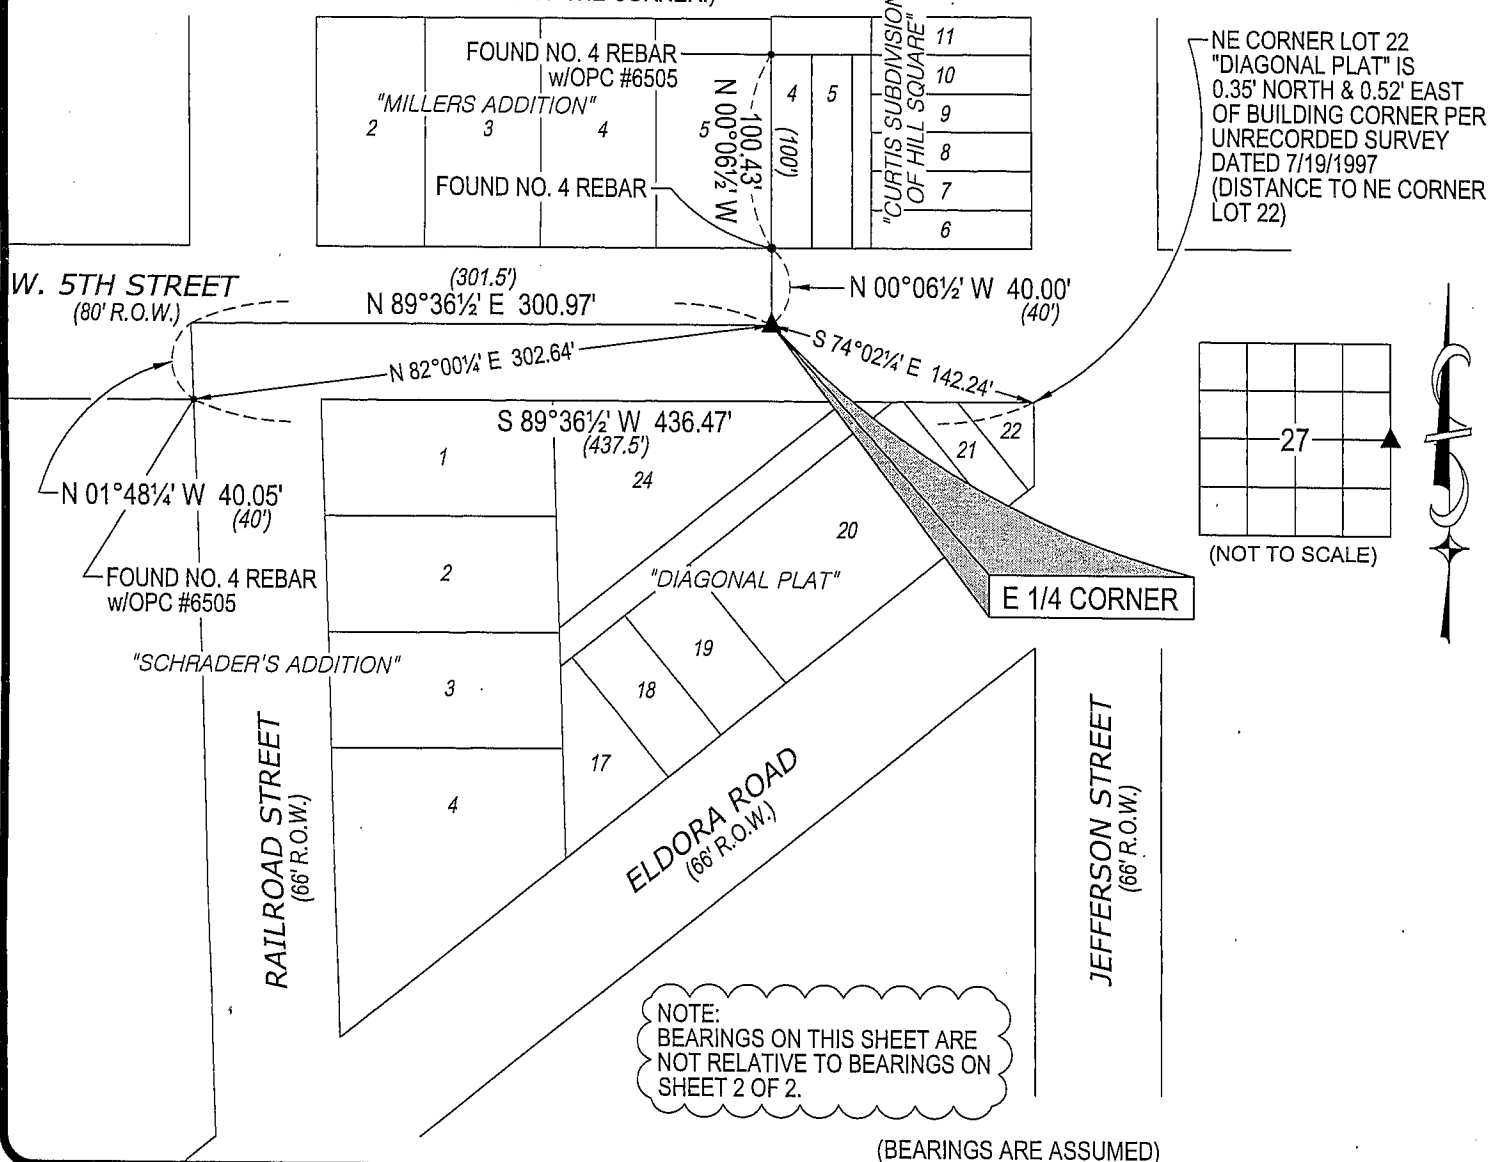
UNITED STATES PUBLIC LAND SURVEY CORNER CERTIFICATE
OFLAND SURVEY MONUMENTS SITUATED IN SECTION NO. 27, TOWNSHIP NO. 88 NORTH, RANGE
NO. 14 WEST OF THE FIFTH PRINCIPAL MERIDIAN, BLACK HAWK COUNTY, IOWA.PREVIOUSLY RECORDED IN N/A(SHOW REASON FOR PREPARING THIS CERTIFICATE, THE EVIDENCE AND DETAILED PROCEDURES USED IN ESTABLISHING THE
CORNER POSITIONS AND MONUMENTATION FOUND OR PLACED.)

MONUMENT DESCRIPTION AND REMARKS:

NO USPLSCC ON FILE. SURVEY COMPLETED IN THE NE 1/4 OF THE SW 1/4 OF SEC. 27-T88N-R14W.

→ **E 1/4 CORNER:** BLACK HAWK COUNTY ENGINEER REFERENCE TIES CALLS FOR [S.C.M.]. ALL TIES
OBLITERATED. NO MONUMENT IN PLACE IN PAVEMENT PRIOR TO CITY OF HUDSON REPLACING w/P.C.C.
PAVEMENT BASED UPON PREVIOUS SURVEY WORK. REESTABLISHED CORNER AT SOUTHERLY EXTENSION
OF THE WEST LINE OF LOT NO. 4 IN "CURTIS SUBDIVISION OF HILL SQUARE", CITY OF HUDSON, CURRENT
SITE OF HUDSON PUBLIC LIBRARY, 40.00' SOUTH OF THE SW CORNER OF SAID LOT NO. 4. CORNER AS
ESTABLISHED CORRESPONDS TO SURVEYS AND MONUMENTS IN "DIAGONAL PLAT" TO THE SOUTH AND
"SCHRADER'S ADDITION" TO THE SOUTHWEST. CUT "X" IN P.C.C. PAVEMENT AT E 1/4 CORNER.

PLAN VIEW

(SHOW A MINIMUM OF THREE REFERENCE TIES TO DURABLE PHYSICAL OBJECTS, RELEVANT MONUMENTS AND PHYSICAL
CONDITIONS THAT WILL ENABLE RECOVERY OF THE CORNER.)

(BEARINGS ARE ASSUMED)

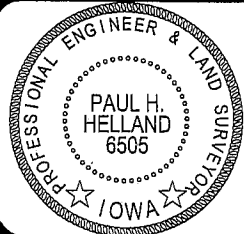
HELLAND ENGINEERING & SURVEYING, LTD.
1107 Technology Parkway
Cedar Falls, Iowa 50613-6951
(319)-266-0161

SHEET 1 OF 2

SHINER = 8D NAIL & 1 5/16"Ø METAL SHINER
BRASS TAG = 13/16"Ø BRASS TAG
OPC = PLASTIC CAP (O=ORANGE, R=RED, Y=YELLOW)
(00') RECORDED AS FILE NAME: 07-172C2.DWG

LIST CORNERS TO BE INDEXED

CORNER	SECTION	TOWNSHIP	RANGE
E 1/4 CORNER	27	88N	14W

I hereby certify that this land surveying document was prepared
and the related survey work was performed by me or under my
direct personal supervision and that I am a duly licensed Land
Surveyor under the laws of the State of Iowa.Paul H. Helland 7/26/07
Paul H. Helland
License Number 6505My license renewal date is December 31, 2007.
All pages or sheets are covered by this seal except:

Rec.