

I  
P  
Z


Document Number: 2008019017  
Date: Mar 31, 2008 4:30:00 pm  
Aud Fee: 0.00 Rec Fee: 5.00  
Trans Tax: 0.00 Rec Management Fee: 1.00  
E-Corn Fee: 1.00 Non-Standard Page Fee: 0.00  
Filed for record in Black Hawk County, Iowa  
Judith A. McCarthy, County Recorder

Kirk D. Eschliman, P.L.S. Iowa Lic. No. 9961, 723 Broadway Street, Waterloo, Iowa 50703 - Phone: 319-234-0509

UNITED STATES PUBLIC LAND SURVEY CORNER CERTIFICATE  
OF

LAND SURVEY MONUMENTS SITUATED IN SECTION 28, TOWNSHIP EIGHTY-EIGHT(88)NORTH  
RANGE FOURTEEN(14)WEST, OF THE FIFTH PRINCIPAL MERIDIAN, BLACK HAWK COUNTY, IOWA.  
PREVIOUSLY RECORDED IN (NOT PREVIOUSLY RECORDED) (BOOK, PAGE, DOCUMENT NUMBER, ETC.) IN THE COUNTY RECORDER'S OFFICE.  
(SHOW REASON FOR PREPARING THIS CERTIFICATE, THE EVIDENCE AND DETAILED PROCEDURES USED IN ESTABLISHING THE CORNER POSITIONS AND MONUMENTATION FOUND OR PLACED.)  
MONUMENT DESCRIPTION AND REMARKS: FOUND CONCRETE MONUMENT WITH BRASS CAP, MARKED AS COMMON  
CORNER FOR SECTIONS 28, 29, 32, & 33. MONUMENT CONTAINS NO MAGNETIC MATERIAL. MONUMENT WAS  
LOCATED 5 INCHES ABOVE CURRENT GROUND SURFACE.

PLAN - VIEW

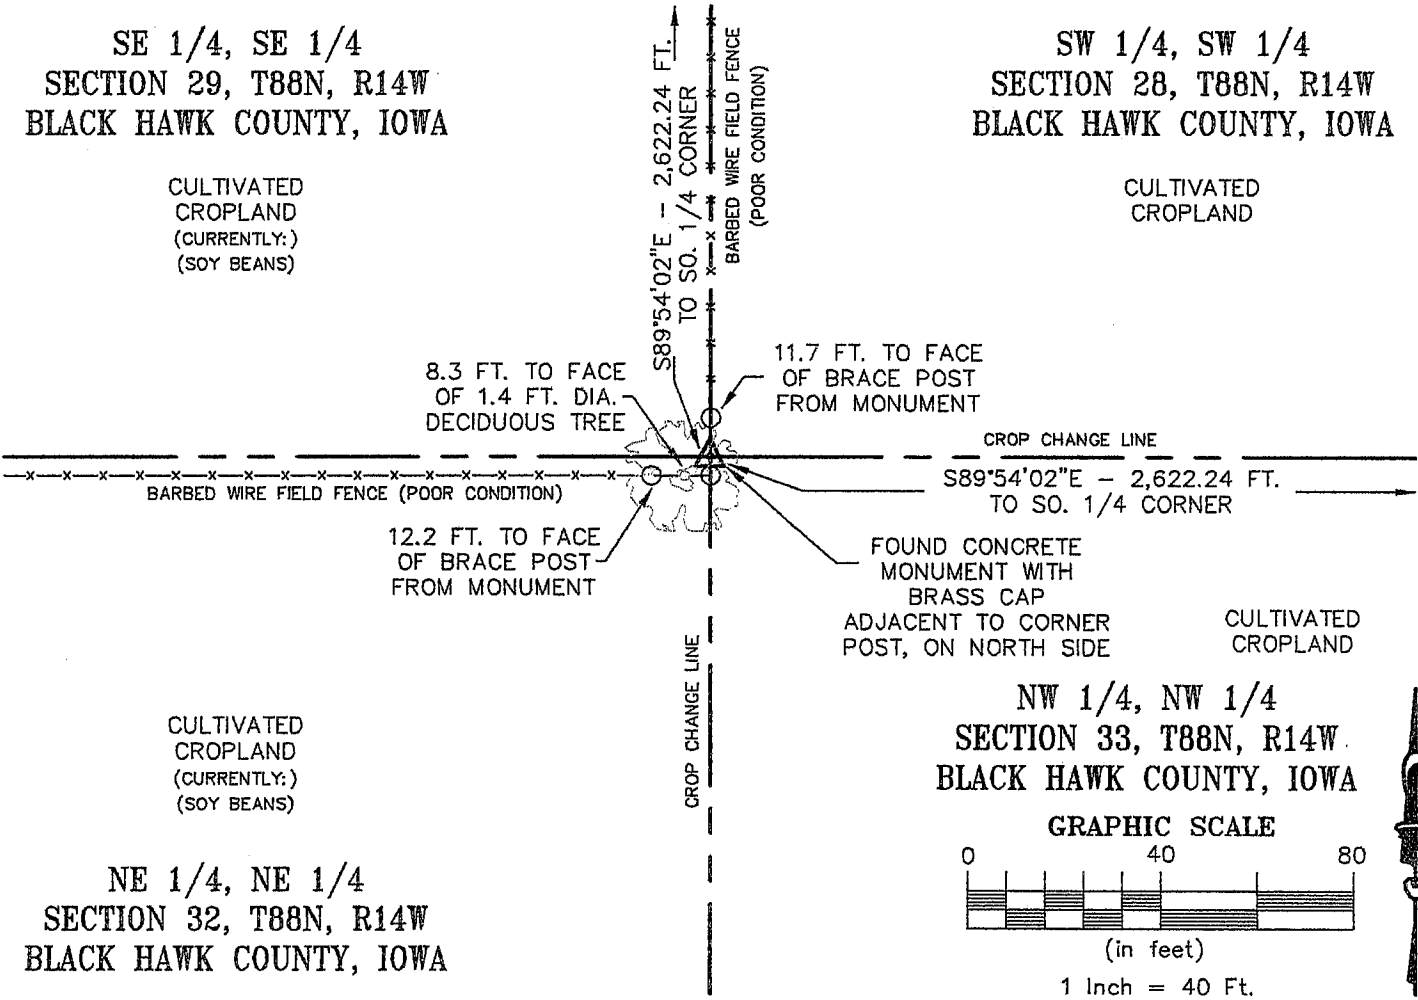

I HEREBY CERTIFY THAT THIS LAND SURVEYING DOCUMENT  
WAS PREPARED AND RELATED SURVEY WORK WAS  
WAS PERFORMED BY ME OR UNDER MY DIRECT PERSONAL  
SUPERVISION AND THAT I AM A DULY LICENSED LAND  
SURVEYOR UNDER THE LAWS OF THE STATE OF IOWA.

*Kirk D. Eschliman* DATE: 08/11/00  
KIRK D. ESCHLIMAN, P.L.S. IOWA LIC. NO. 9961  
MY LICENSE RENEWAL DATE IS DECEMBER 31, 2001  
PAGES OR SHEETS COVERED BY THIS SIGNATURE & SEAL: SHEET 1 OF 1

FOR: LYLE D. TAYLOR  
6721 WATERS ROAD  
BLACK HAWK COUNTY, IOWA

REQ. BY: LYLE TAYLOR  
WATERLOO, IOWA



KESS & ASSOCIATES, INC.  
PROFESSIONAL LAND SURVEYORS : 723 BROADWAY, WATERLOO, IOWA 50703-5811  
DATE: 08/11/00 C.A.D.D. FILE: 00B14CCA.DWG PROJECT NO.: 00B14

List of corners to be indexed:

Corners	Section	Township	Range
SW	28	T88N	R14W

SECTION 28

