



Env
*

Prepared by & Return to: Herold - Reicks Surveying, 2206 East Bremer Avenue, Waverly, IA 50677, Ph. 319-483-5187

United States Public Land Survey Corner Certificate

Land Survey Monument situated in
Section **31**, Township **88** North, Range **14** West of the Fifth Principal Meridian, **Black Hawk** County, Iowa.
On file in **Document #2006-21249** in the County Recorder's office.

This certificate is being prepared in compliance with Iowa Code Chapter 355.11 because:


-
- ☐ There is no certificate on file for this corner.
 - ☐ There are no longer three valid ties of record.
 - ☐ There are changes to reference ties of record.
 - ☒ There is change of monumentation of record.
 - ☐ To clarify description of record monument (ties).

Monument Description and Remarks:

Northeast Corner NW 1/4-SW 1/4: The previously recorded Section Corner Certificate, indicates Found PK Nail, said monument was removed during highway reconstruction. The position of said Section Corner was reestablished with information obtained from previously recorded Section Corner Certificate. Set 1"Ø Bronze Survey Marker PLS 22468 at said position to perpetuate the Corner. Corner reset in conjunction with Project No. STP-S-C007(148)--5E-07.

Plan View

(Show a minimum of three reference ties to durable physical objects, relevant monuments and physical conditions that will enable recovery of the corner.)

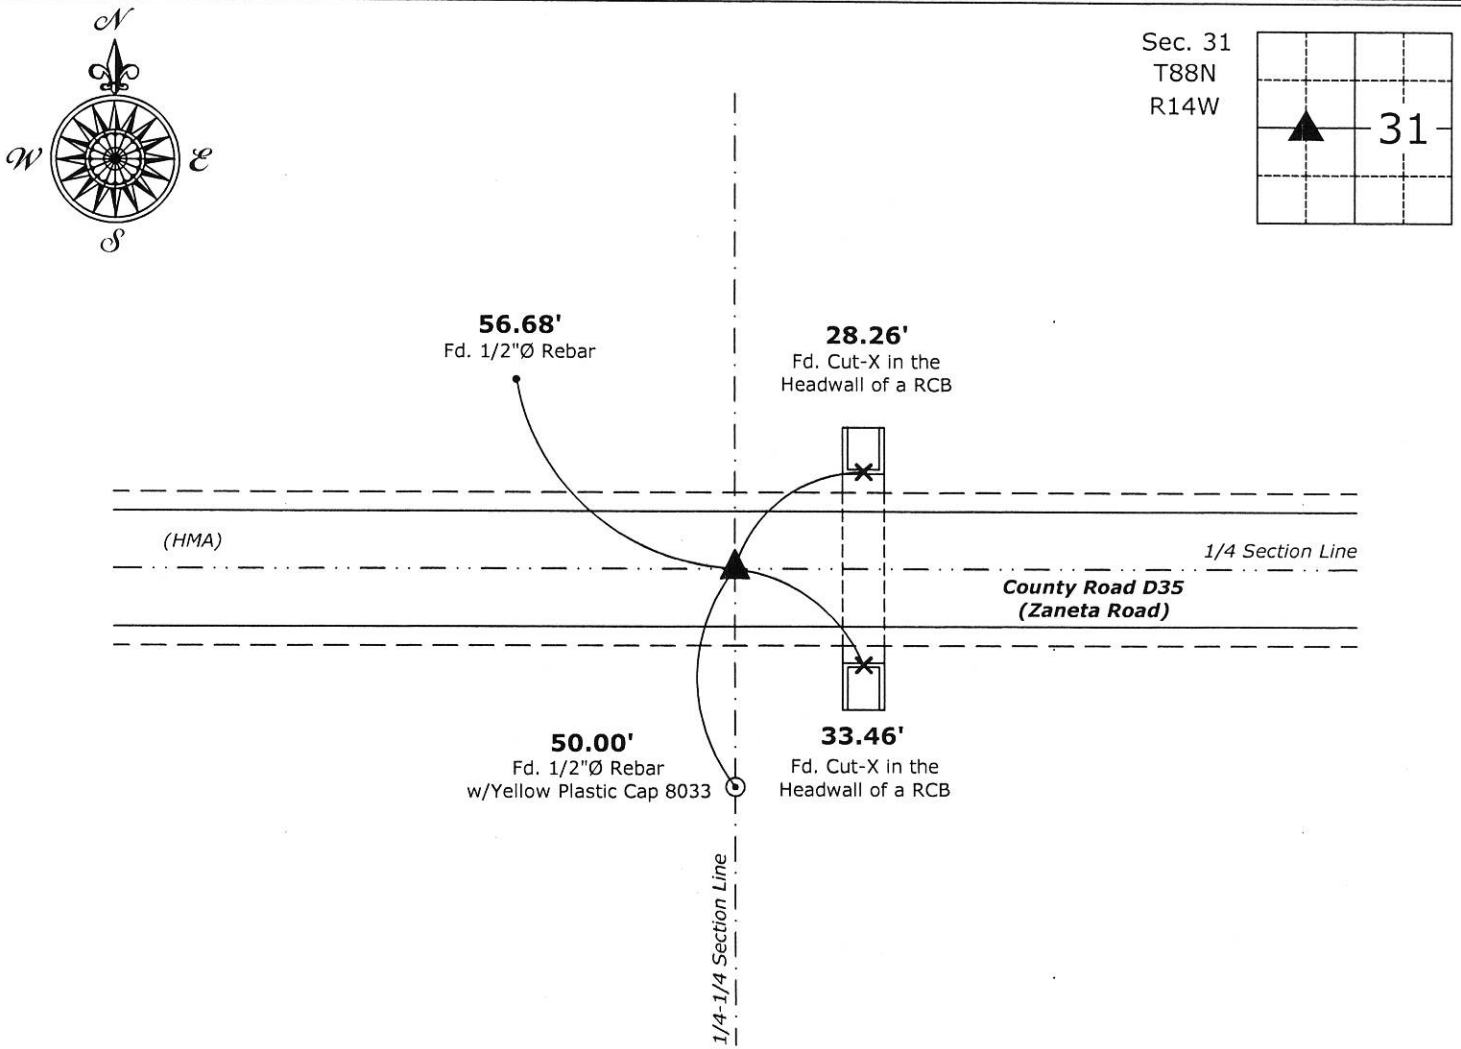

Northeast Corner NW 1/4-SW 1/4 of Section 31-88-14
Set 1"Ø Bronze Survey Marker PLS 22468



I hereby certify that this land surveying document was prepared and the related survey work was performed by me or under my direct personal supervision and that I am a duly licensed Land Surveyor under the laws of the State of Iowa.
Isaiah M. Reicks 2-25-19
Isaiah M. Reicks Date:
License number 22468
My license renewal date is December 31, 2019.
Sheets covered by this seal: Individual sheet only

List Corner to be Indexed			
Corner	Section	Twp.	Range
NE-NW-SW	31	88	14
Project Number: 2018-854			
FB: Black Hawk 10, Pg. 36			

File: I:_Projects - WO\2018\Construction\2018-854 Hudson - Zaneta Road\2018-854.dwg, 2/25/2019 3:21:43 PM