

BLACK HAWK COUNTY IOWA:SS
Filed for record JUL 20, 2000 at
1:00 P.M. and recorded in Book _____
of _____ Page _____

INDEX
MARGIN
PROOF
COMPARE

01 _____ Page _____
Cathleen S. Luss _____ RECORDER
 FEE 1-5.00/
 -WAYNE CLAASSEN ENGINEERING AND SURVEYING INC.-

WAYNE CLAASSEN ENGINEERING AND SURVEYING, INC.
P.O. BOX 898 WATERLOO, IOWA 50704-0898

PHONE: (VOICE) 319-235-6294
(FAX) 319-235-0028

UNITED STATES PUBLIC LAND SURVEY CORNER CERTIFICATE


Previously recorded in N/A in County Recorder's Office.
(book, page, document number, etc.)

Show reason for preparing this certificate, the evidence and detailed procedures used in establishing the corner positions and monumentation found or placed.)

Monument Description and Remarks SW Cor. 31-88-14 Found 5/8" rebar 4" deep in
gravel per B.H. Co. Ties. (4' ± West of E gravel)

PLAN - VIEW

Show a minimum of three reference ties to durable physical objects, relevant monuments and physical conditions that will enable recovery of the corner.)

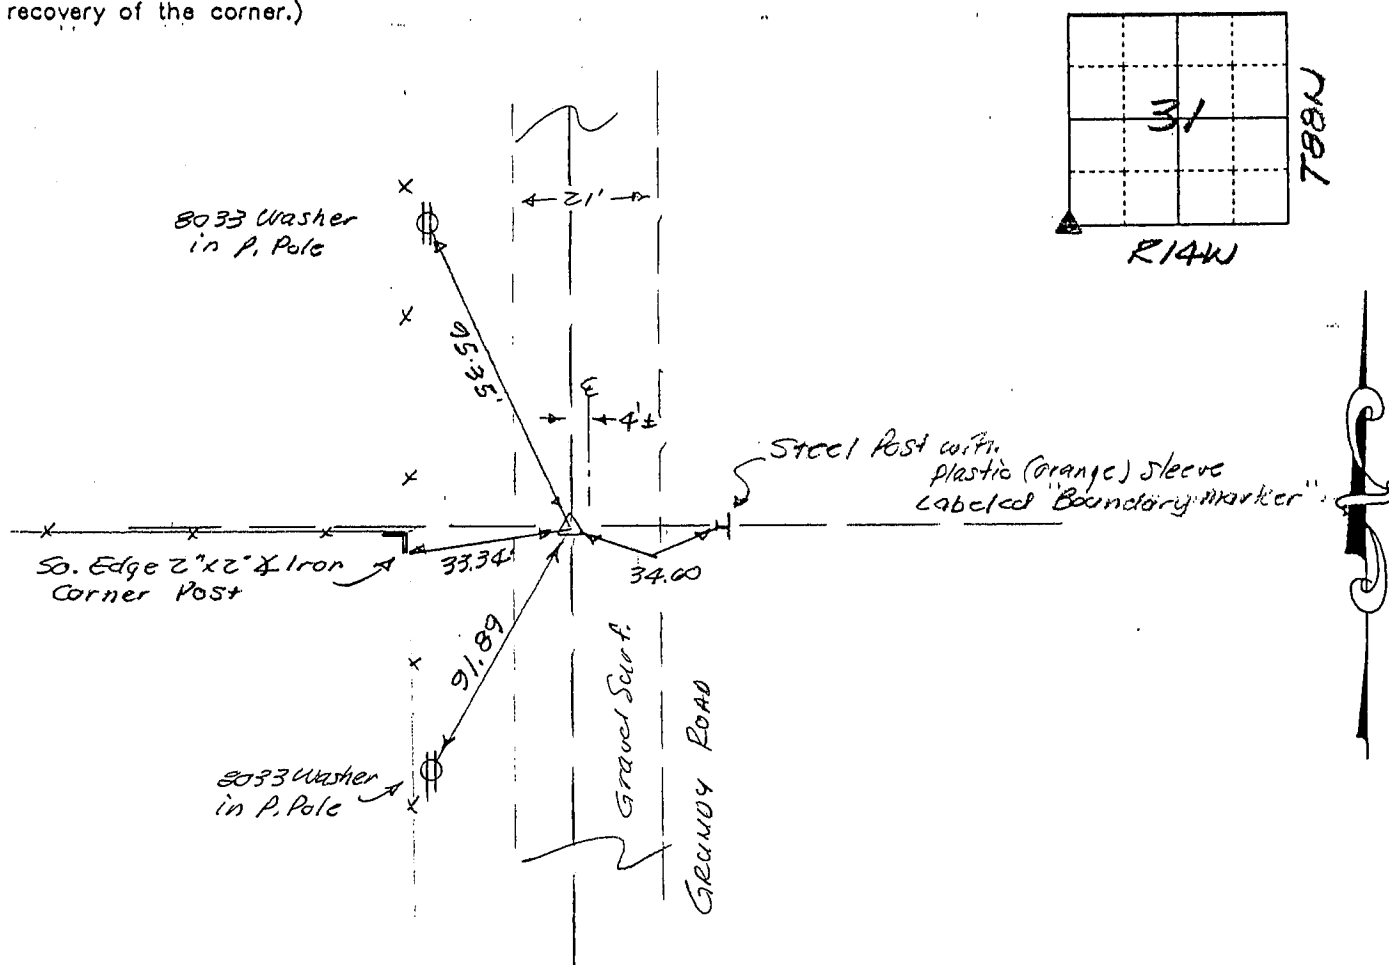

484-50

I hereby certify that the survey work was completed and this certificate was prepared by me or under my direct personal supervision and that I am a duly licensed land surveyor under the laws of the state of Iowa.

Signature:


F. William King
(Name typed or printed:) *F. William King*


SEAL

List Corners to be Indexed

Corners	Section	Twp	Range
SW	31	88N	14W

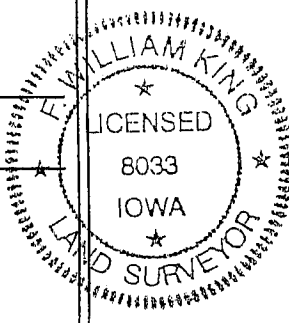

BOOK 339 PAGE 367