

SC ✓
MISC
INDEX *Cy*
MARGIN
PROOF *or*
COMPARE

BLACK HAWK COUNTY IOWA:SS
Filed for record May 18, 19 98 at
4:00 P .M. and recorded in Book 330
of MISC Page 78
Catherine A. Soss Recorder
FEE 1-5.00/
WAYNE CLAASSEN ENGINEERING AND SURVEYING, INC.

23761

WAYNE CLAASSEN ENGINEERING AND SURVEYING, INC.
P.O. BOX 898 WATERLOO, IOWA 50704-0898

PHONE: (VOICE) 319-235-6294
(FAX) 319-235-0028

UNITED STATES PUBLIC LAND SURVEY CORNER CERTIFICATE


Land Survey Monuments situated in Section 32, Township 88N, Range 14W, of the Fifth Principal Meridian, BLACK HAWK County, Iowa.
Previously recorded in N/A in County Recorder's Office.
(book, page, document number, etc.)

(Show reason for preparing this certificate, the evidence and detailed procedures used in establishing the corner positions and monumentation found or placed.)

Monument Description and Remarks CENTER SECTION: FOUND 1/2" & BEING FLUSH WITH
SURFACE OF A/C PAVT. PER Co. TIES.

PLAN - VIEW

(Show a minimum of three reference ties to durable physical objects, relevant monuments and physical conditions that will enable recovery of the corner.)

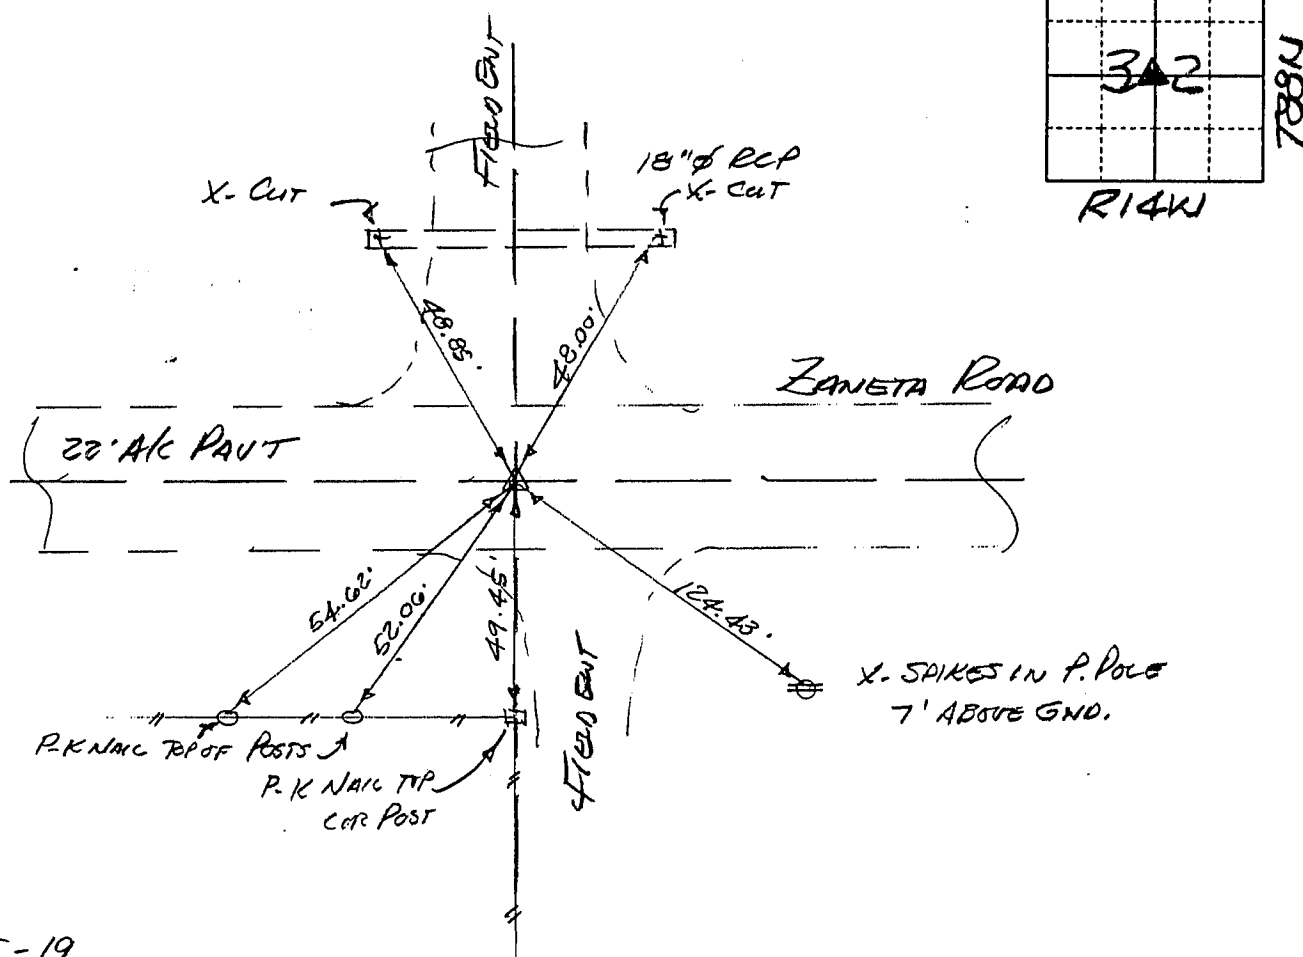

485-19

I hereby certify that the survey work was completed and this certificate was prepared by me or under my direct personal supervision and that I am a duly licensed land surveyor under the laws of the state of Iowa.


Signature: *F. William King*
(Name typed or printed:) F. WILLIAM KING

Date: 5-18-1998 Lic. No. 8033

SEAL

List Corners to be Indexed

Corners	Section	Twp	Range
CENTER	32	88N	14W

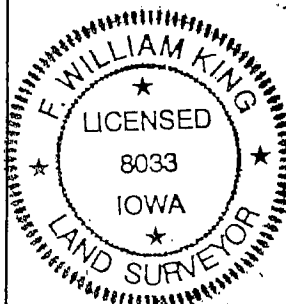

BOOK 330 PAGE 078