

PREPARED BY: **BLACK HAWK COUNTY ENGINEERS OFFICE**  
316 E. FIFTH STREET, ROOM 211 WATERLOO, IOWA 50703  
PH.# (319) 833-3008  
FAX.# (319) 833-3139  
SLSI 9-94  
BHCO 03-09


UNITED STATES PUBLIC LAND SURVEY CORNER CERTIFICATE OF  
Land Survey Monuments situated in Section 34, Township 88 N,  
Range 14 W, of the Fifth Principal Meridian, BLACK HAWK County, Iowa.  
Previously recorded in File Book N/A, Page N/A, in County Recorder's Office.  
(Show reason for preparing this certificate): There is No Certificate for the corner on file with County Recorder, per  
Ia. Code 355.11(1)(a).

(Evidence and detailed procedures used in establishing the corner position(s) and monumentation found or placed.)  
Monument Description and Remarks: CENTER of SECTION  
FOUND #4 (1/2") REBAR WITH YELLOW PLASTIC CAP (Y.P.C.) #9961, PER PLAT OF SURVEY  
FILE 2011-005674, WITH NO CURRENT CERT. OF RECORD. CORNER REFERENCED AS PART  
OF ACQ. PLAT IN N.W. 1/4 SAID SECTION (ALONG ELDORA RD.). EXISTING DATED FENCE  
POST LOCATED ±3' EAST OF FOUND CENTER, YET NO AREA CORNER TIES ESTABLISHED.  
LAND CORNER TIES TO W. 1/4 AND N. 1/4 CORNERS USED (PER ACQ. PLAT MEASURE) FOR  
CORNER TIE REFERENCES, IN ADDITION TO E. 1/4 CORNER AND S.W. COR. OF PARCEL "B"  
OF SAID PLAT PER PLATTED REFERENCES. CORNER FOUND ±3" ABOVE GROUND.

PLAN VIEW  
"NOT TO SCALE"

BHco Hist. Ties: N/A  
FIELD BOOK: FC2500 TopSurv V8.2.3 project

(Show a minimum of three reference ties to durable physical objects, relevant monuments and physical conditions  
that will enable recovery of the corner.)

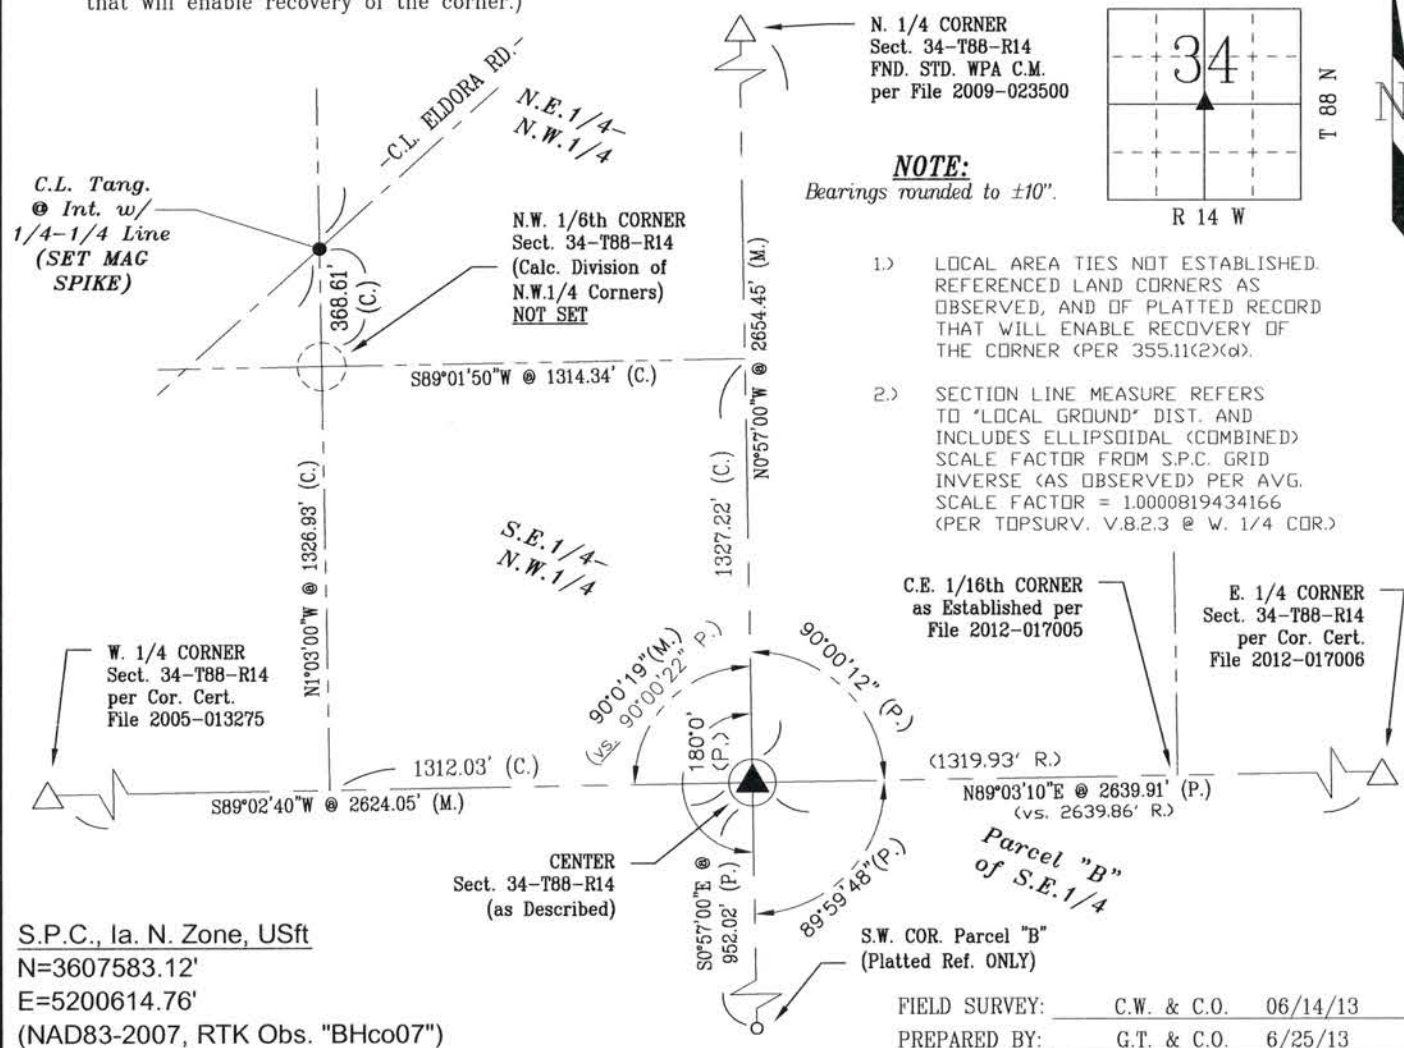

CERTIFICATION



I hereby certify that this land surveying document was prepared and the related survey work was performed by me or under my direct personal supervision and that I am a duly licensed Land Surveyor under the laws of the State of Iowa.  
Geoffry Allen Tinker (date) 06/25/2013  
License Number 15748  
My license renewal date is December 31, 2014  
Pages or sheets covered by this seal:  
This Land Corner Certificate Only.

LIST CORNERS TO BE INDEXED

Corner	Section -	Township -	Range
CENTER	34	88 N	14 W

INDEX OF ABBREVIATIONS

- (M) = "Measured" Dimension
- (P) = "Platted" Dimension
- (R) = "Record" Dimension
- (C) = "Calculated" Dimension
- "IGS" = Iowa Geodetic Survey
- "WPA" = Works Progress Admin. Survey
- "G" = per George Miller Survey (BHco Surveyor 1858-1860)
- "B" = per John Ball Survey (BHco Surveyor 1866-1891)
- "N" = per Nathan Barber Survey (BHco Surveyor 1908-1931)
- "NP" = Reflectorless EDM Meas.
- "MLM" = Indirect Measure
- "CM" = Concrete Monument
- "SM" = Survey Marker Spike/Tag
- "PK" = PK/MAG Nail Brand Style