020083

BLACK HAWK COUNTY IOWA:SS
Filed for record MAR 29, 2000 at
1:00 P.M. and recorded in Book _____
of _____ Page _____
Patricia A. Sass RECORDER
FEE 1-5.00/ _____.
WAYNE CLAASSEN ENGINEERING & SURVEYING INC

INDEX ☑
MARGIN
PROOF
COMPARE

WAYNE CLAASSEN ENGINEERING AND SURVEYING, INC.
P.O. BOX 898 WATERLOO, IOWA 50704-0898
PHONE: (VOICE) 319-235-6294
(FAX) 319-235-0028

UNITED STATES PUBLIC LAND SURVEY CORNER CERTIFICATE

and Survey Monuments situated in Section 34, Township 88N, Range 14W, of the Fifth Principal Meridian, BLACK HAWK County, Iowa.

Previously recorded in N/A (book, page, document number, etc.) in County Recorder's Office.

Show reason for preparing this certificate, the evidence and detailed procedures used in establishing the corner positions and monumentation found or placed.)

Monument Description and Remarks East 1/4 CORNER, FOUND CONE HEAD NAIL IN ASPHALT PER FINAL PLAT GLENWOOD CHASE 1ST. ADDITION (PLATS RECORD W, Page 161, Jan 15, 199. Also, see Misc record - Plat of Survey Misc. 218-540, 1977.

PLAN - VIEW

Show a minimum of three reference ties to durable physical objects, relevant monuments and physical conditions that will enable recovery of the corner.)

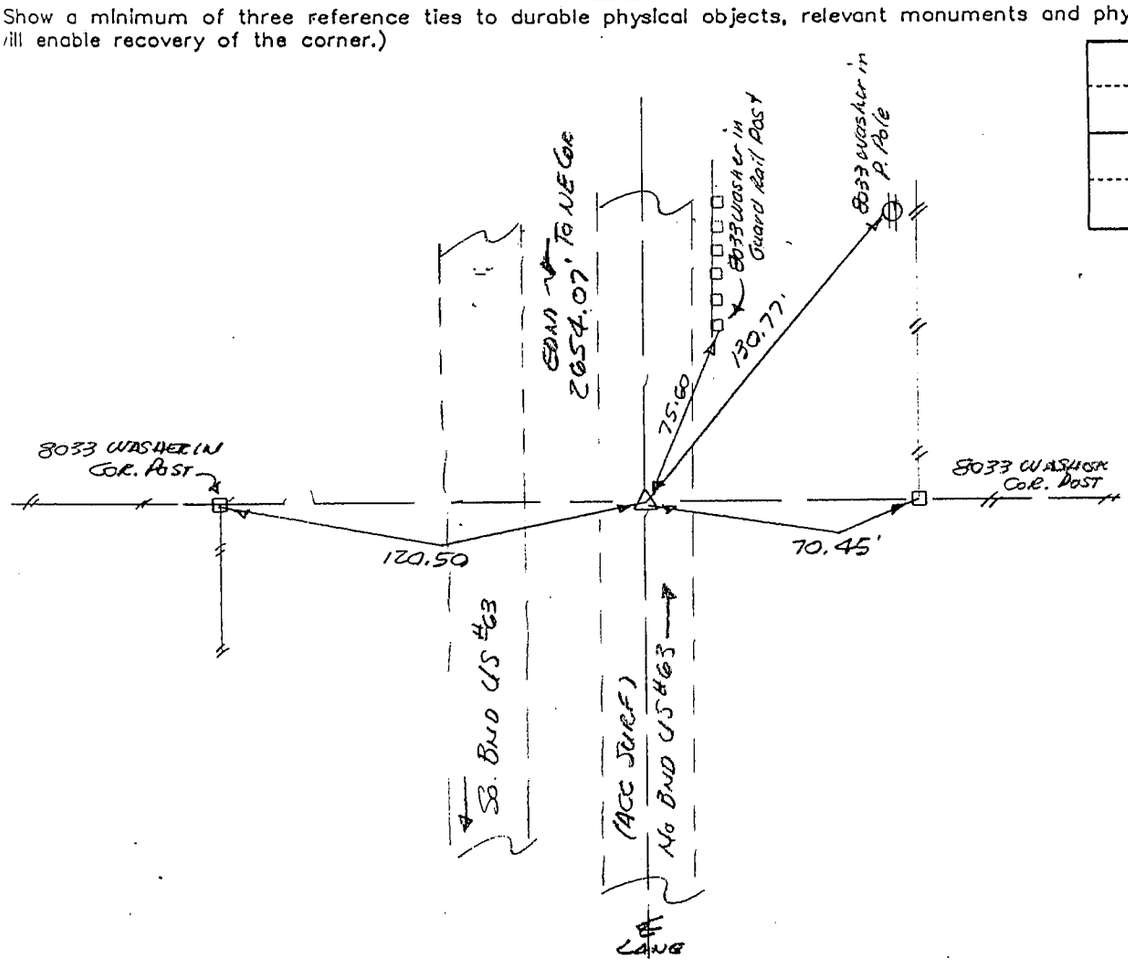

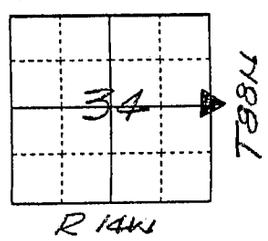

320-80

I hereby certify that the survey work was completed and this certificate was prepared by me or under my direct personal supervision and that I am a duly licensed land surveyor under the laws of the state of Iowa.

Signature: F. William King
(Name typed or printed:) F. William King
Date: March 28, 2000 Lic. No. 8033

SEAL

List Corners to be Indexed

Corners	Section	Twp	Range
E 1/4	34	88N	14W

F. WILLIAM KING LICENSED 8033 IOWA LAND SURVEYOR