



Doc ID: 005279810001 Type: GEN
Kind: SURVEY
Recorded: 09/16/2013 at 12:13:13 PM
Fee Amt: \$7.00 Page 1 of 1
Black Hawk County Iowa
JUDITH A MCCARTHY RECORDER
File **2014-00006067**

** Prepared by & Return to: Herald - Reicks Surveying, 10 East Main Street, New Hampton, IA 50659, Ph. 641-394-2725*

UNITED STATES PUBLIC LAND SURVEY CORNER CERTIFICATE

Land Survey Monuments situated in Section **34**, Township **88** North, Range **14** West of the Fifth Principal Meridian, **Black Hawk** County, Iowa. Previously recorded in Document #2012-17006 in the County Recorder's office.

This certificate is being prepared in compliance with Iowa Code Chapter 355.11 because:




- ☐ There is no certificate on file for this corner.
- ☐ There are no longer three valid ties of record.
- ☐ There are changes to reference ties of record.
- ☒ There is change of monumentation of record.
- ☐ To clarify description of record monument (ties).

Monument Description and Remarks:

East 1/4 Corner: Set 1"Ø Bronze Survey Marker PLS 19211 in PCC pavement at previous location (Found MAG Nail w/Washer PLS 16775) by means of coordinates obtained prior to highway reconstruction, IDOT Project No. NHSX-063-6(89)--3H-07.

PLAN - VIEW

(Show a minimum of three reference ties to durable physical objects, relevant monuments and physical conditions that will enable recovery of the corner.)

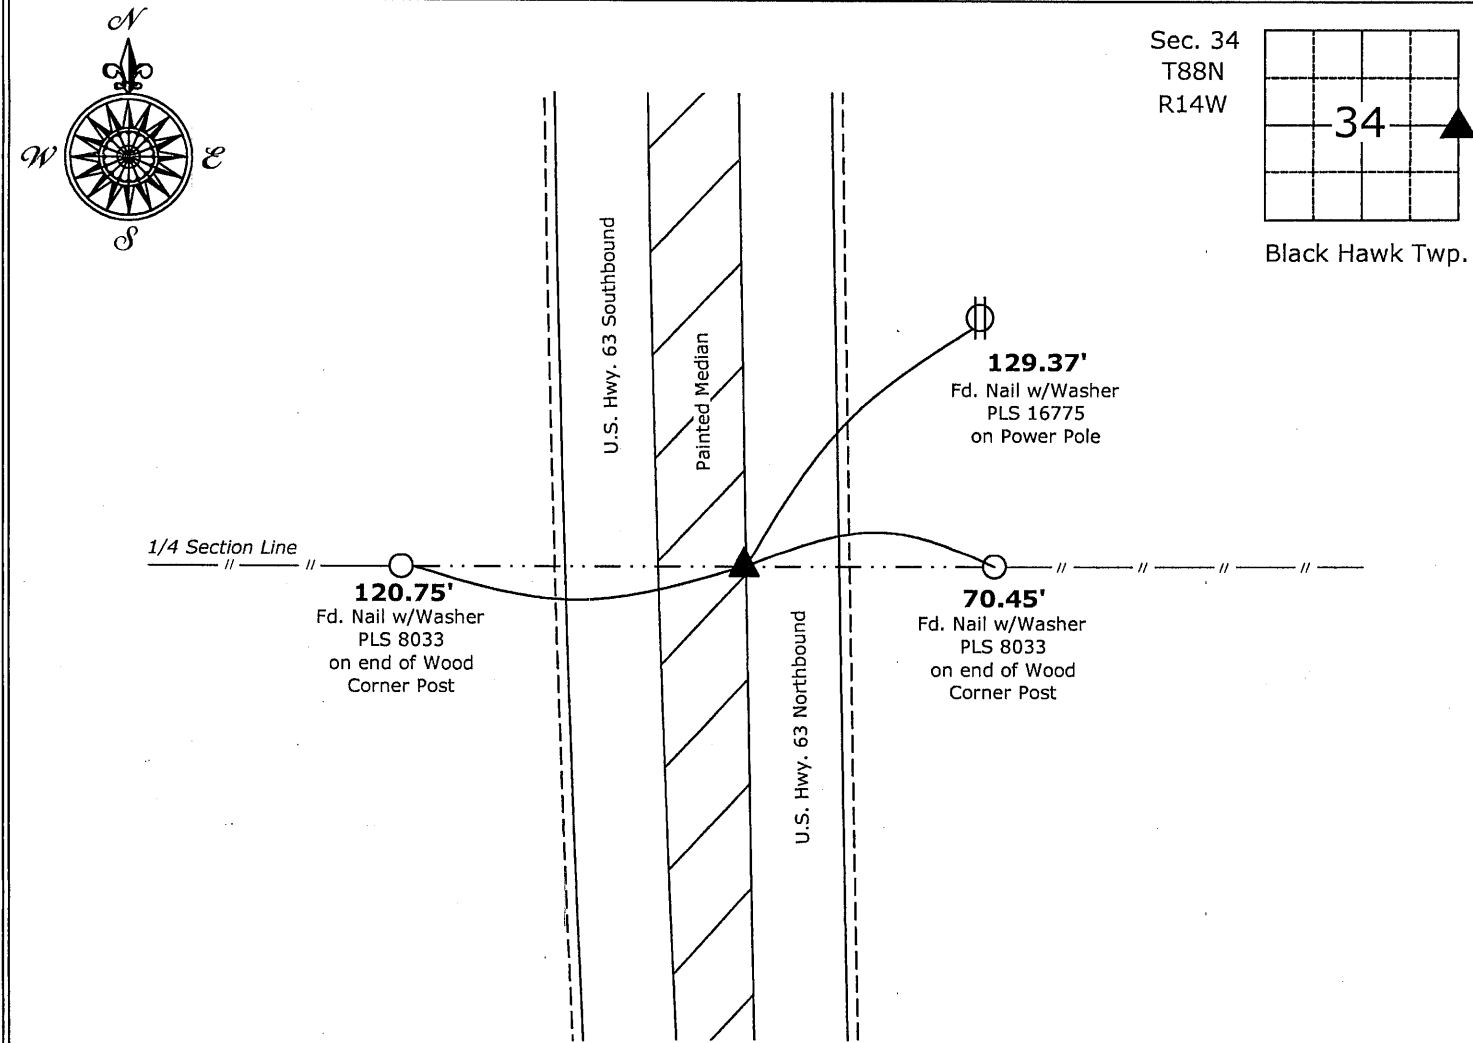

East 1/4 Corner Section 34-88-14
Set 1"Ø Bronze Survey Marker PLS 19211 in PCC Pavement



I hereby certify that this land surveying document was prepared and the related survey work was performed by me or under my direct personal supervision and that I am a duly licensed Land Surveyor under the laws of the State of Iowa.
Kirk D. Reicks 9-11-13
Kirk D. Reicks Date:
License number 19211
My license renewal date is December 31, 2014.
Sheets covered by this seal: Individual sheet only

List Corners to be Indexed			
Corners	Section	Twp.	Range
E 1/4	34	88	14
Project Number: 2013-066			

7.003m