



Doc ID: 004026040001 Type: GEN  
Kind: CORNER  
Recorded: 01/12/2010 at 03:21:09 PM  
Fee Amt: \$9.00 Page 1 of 1  
Black Hawk County Iowa  
JUDITH A MCCARTHY RECORDER  
File **2010-00013409**

\* Paul H. Helland, 1107 Technology Parkway, Cedar Falls, Iowa 50613-6951, (319)-266-0161

# UNITED STATES PUBLIC LAND SURVEY CORNER CERTIFICATE OF

LAND SURVEY MONUMENTS SITUATED IN SECTION NO. 36, TOWNSHIP NO. 88 NORTH, RANGE NO. 14 WEST OF THE FIFTH PRINCIPAL MERIDIAN, BLACK HAWK COUNTY, IOWA.  
PREVIOUSLY RECORDED IN N/A

(SHOW REASON FOR PREPARING THIS CERTIFICATE, THE EVIDENCE AND DETAILED PROCEDURES USED IN ESTABLISHING THE CORNER POSITIONS AND MONUMENTATION FOUND OR PLACED.)


## MONUMENT DESCRIPTION AND REMARKS:

NO USPLSCC ON FILE. SURVEY COMPLETED IN THE NW 1/4 OF SEC. 36-T88N-R14W.

→ E 1/4 CORNER: W.P.A. NOTES DATED 10/3/1938 CALLS FOR [FOUND NIGGER HEAD 16"x15"x10" ALSO IRON BAR 1"x23" LOWERED EVIDENCE AND SET C.M. ON TOP 12" UNDERGROUND.]. PLAT OF SURVEY 276 MISC. 628 DATED 10/10/1987 CALLS FOR [FO. PIN]. PLAT OF SURVEY 299 MISC. 669 DATED 12/5/1991 CALLS FOR [FOUND 3/4"Ø REBAR]. PLAT OF SURVEY 316 MISC. 951 DATED 8/3/1995 AND AND PLAT OF SURVEY 328 MISC. 925-926 DATED 10/6/1997 CALLS FOR [FOUND PIN]. FOUND NO. 6 REBAR 0.3'± DEEP, 1.3'± NORTH OF ELY EXTENSION OF FENCE RUNNING WEST.

## PLAN VIEW

(SHOW A MINIMUM OF THREE REFERENCE TIES TO DURABLE PHYSICAL OBJECTS, RELEVANT MONUMENTS AND PHYSICAL CONDITIONS THAT WILL ENABLE RECOVERY OF THE CORNER.)

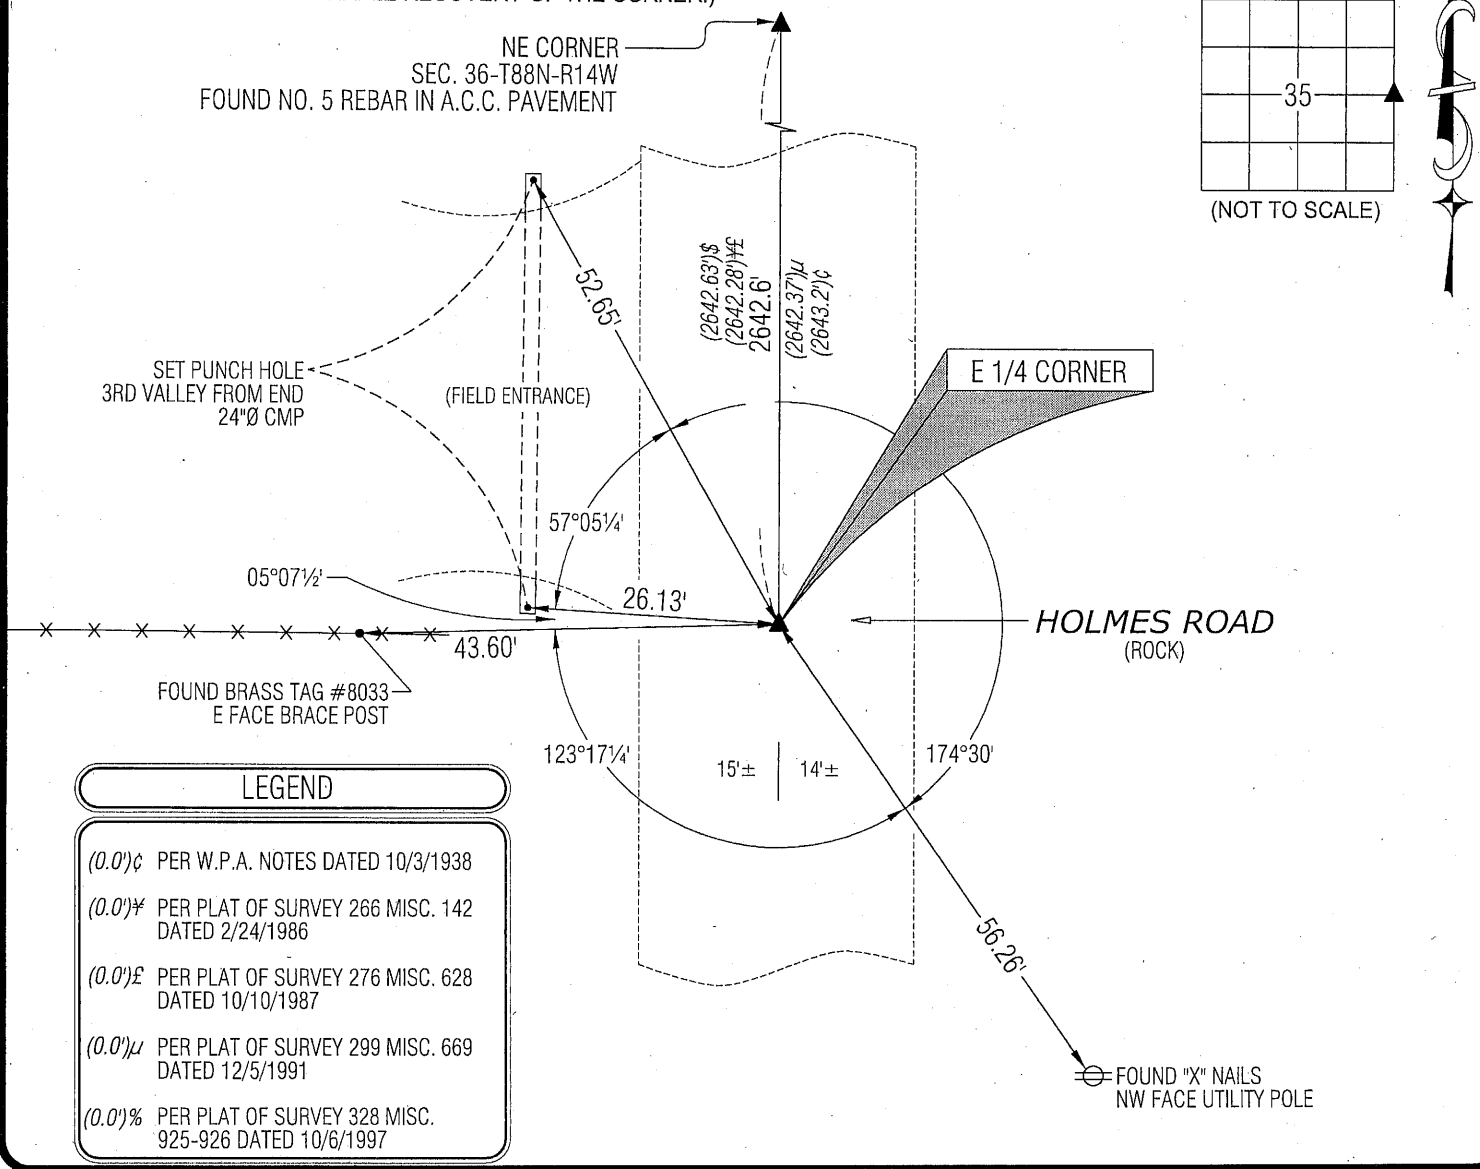

**HELLAND ENGINEERING & SURVEYING, LTD.**  
1107 Technology Parkway  
Cedar Falls, Iowa 50613-6951

SHINER = 8D NAIL & 1 5/16"Ø METAL SHINER  
BRASS TAG = 13/16"Ø BRASS TAG  
OPC = PLASTIC CAP (O=ORANGE, R=RED, Y=YELLOW)  
(00') RECORDED AS FILE NAME: 09-153C2.DWG

CORNER	SECTION	TOWNSHIP	RANGE
E 1/4 CORNER	35	88N	14W
W 1/4 CORNER	36	88N	14W

I hereby certify that this land surveying document was prepared and the related survey work was performed by me or under my direct personal supervision and that I am a duly licensed Land Surveyor under the laws of the State of Iowa.  
*Paul H. Helland* 10/11/09  
Paul H. Helland  
License Number 6505  
My license renewal date is December 31, 2009.  
All pages or sheets are covered by this seal except: