



Doc ID: 012051340001 Type: GEN
Recorded: 12/20/2023 at 11:32:28 AM
Fee Amt: \$7.00 Page 1 of 1
Black Hawk County Iowa
SANDIE L. SMITH RECORDER

File 2024-00008023

PREPARED BY / RETURN TO: MIRANDA K. EILDERS IOWA DEPARTMENT OF TRANSPORTATION 428 43rd ST. SW MASON CITY, IA 50401 641-423-7584

UNITED STATES PUBLIC LAND SURVEY CORNER CERTIFICATE
OF

Land Survey Monuments situated in Section 35, Township 88N, Range 14W
of the Fifth Principal Meridian, BLACK HAWK County, Iowa.


Previously recorded in FILE 2012-00017008 in County Recorder's Office.
(book, page, document number, etc.)

(Show reason for preparing this certificate, the evidence and detailed procedures used in establishing the corner positions and monumentation found or placed.)

Monument Description and Remarks: NW CORNER: REPLACED PREVIOUSLY FOUND MAG NAIL
WITH MAG SPIKE/IDOT WASHER #22293 9' EAST $\frac{1}{4}$ IA 58 PER CERT OF RECORD
FILE #2012-00017008 AFTER 2023 HMA RESURFACING PROJECT *NHSX-058-1(100)--3H-07.
REASON FOR CERT: MONUMENTATION AND TIES HAVE CHANGED.

PLAN - VIEW

(Show a minimum of three reference ties to durable physical objects, relevant monuments and physical conditions that will enable recovery of the corner.)

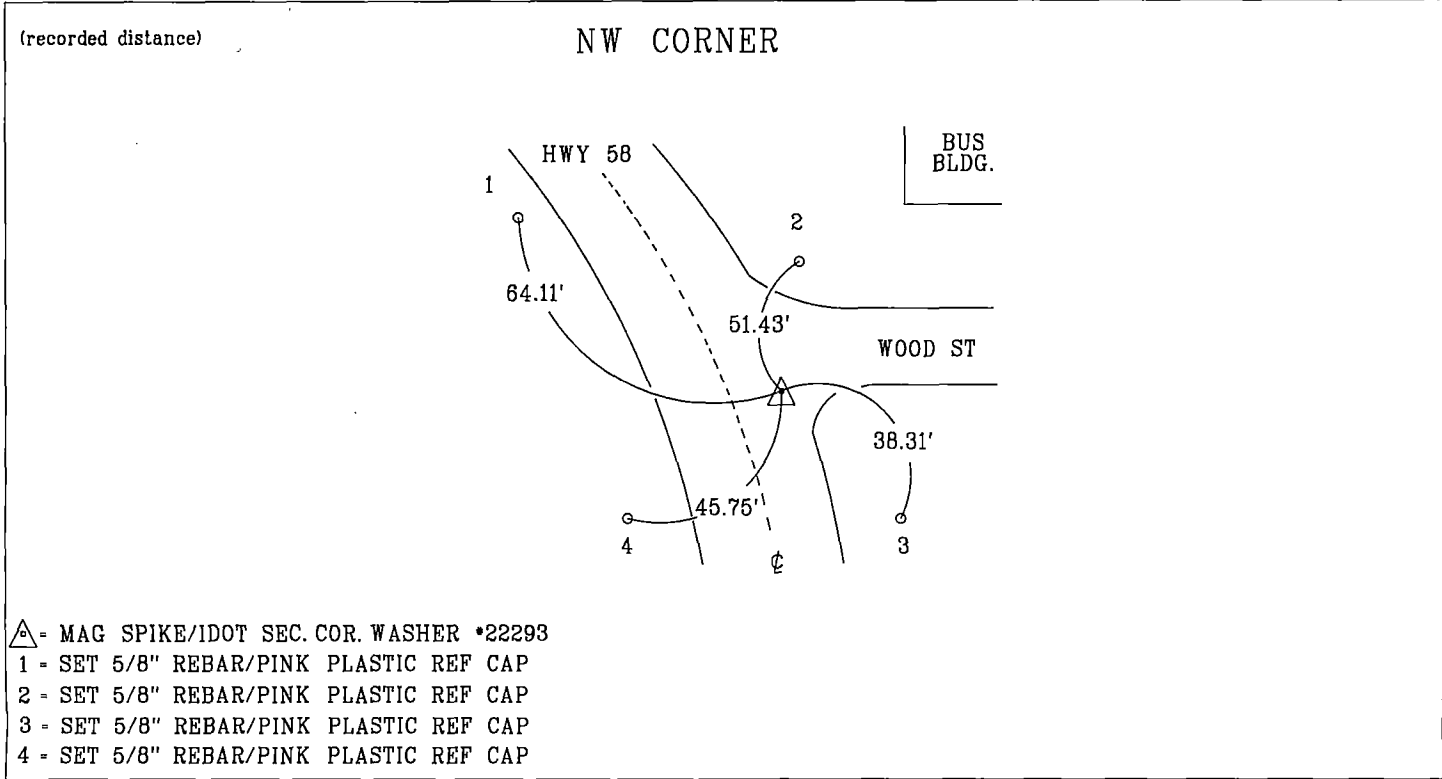

I hereby certify that this land surveying document was
under my personal supervision and that I am duly licensed
professional Land Surveyor under the laws of the state of Iowa.
Miranda K. Eilders 12-13-2023
Miranda K. Eilders Date
License number 22293
My License renewal date is December 31, 2023
Pages or sheets covered by this seal. 1

List Corners to be Indexed			
Corner	Section	Township	Range
NW CORNER	35	88N	14W