



Doc ID: 004026030001 Type: GEN  
Kind: CORNER  
Recorded: 01/12/2010 at 03:20:56 PM  
Fee Amt: \$9.00 Page 1 of 1  
Black Hawk County Iowa  
JUDITH A MCCARTHY RECORDER

File 2010-00013408

Paul H. Helland, 1107 Technology Parkway, Cedar Falls, Iowa 50613-6951, (319)-266-0161

## UNITED STATES PUBLIC LAND SURVEY CORNER CERTIFICATE OF

LAND SURVEY MONUMENTS SITUATED IN SECTION NO. 36, TOWNSHIP NO. 88 NORTH, RANGE  
NO. 14 WEST OF THE FIFTH PRINCIPAL MERIDIAN, BLACK HAWK COUNTY, IOWA.

PREVIOUSLY RECORDED IN N/A

(SHOW REASON FOR PREPARING THIS CERTIFICATE, THE EVIDENCE AND DETAILED PROCEDURES USED IN ESTABLISHING THE  
CORNER POSITIONS AND MONUMENTATION FOUND OR PLACED.)


### MONUMENT DESCRIPTION AND REMARKS:

NO USPLSCC ON FILE. SURVEY COMPLETED IN THE NW 1/4 OF SEC. 36-T88N-R14W.

→ NE CORNER SW 1/4 NW 1/4: NO BLACK HAWK COUNTY ENGINEER'S REFERENCE TIES AVAILABLE. PLAT OF SURVEY 266  
MISC. 142 DATED 2/24/1986 AND PLAT OF SURVEY 276 MISC. 628 DATED 10/10/1987 CALLS FOR [SET PIN W/REG. CAP].  
PLAT OF SURVEY 316 MISC. 951 DATED 8/3/1995 AND PLAT OF SURVEY 328 MISC. 925-926 DATED 10/6/1997 CALLS FOR  
[FOUND PIN W/CAP #6505]. FOUND NO. 4 REBAR W/OPC #6505.


### PLAN VIEW

(SHOW A MINIMUM OF THREE REFERENCE TIES TO DURABLE PHYSICAL OBJECTS, RELEVANT MONUMENTS AND PHYSICAL  
CONDITIONS THAT WILL ENABLE RECOVERY OF THE CORNER.)

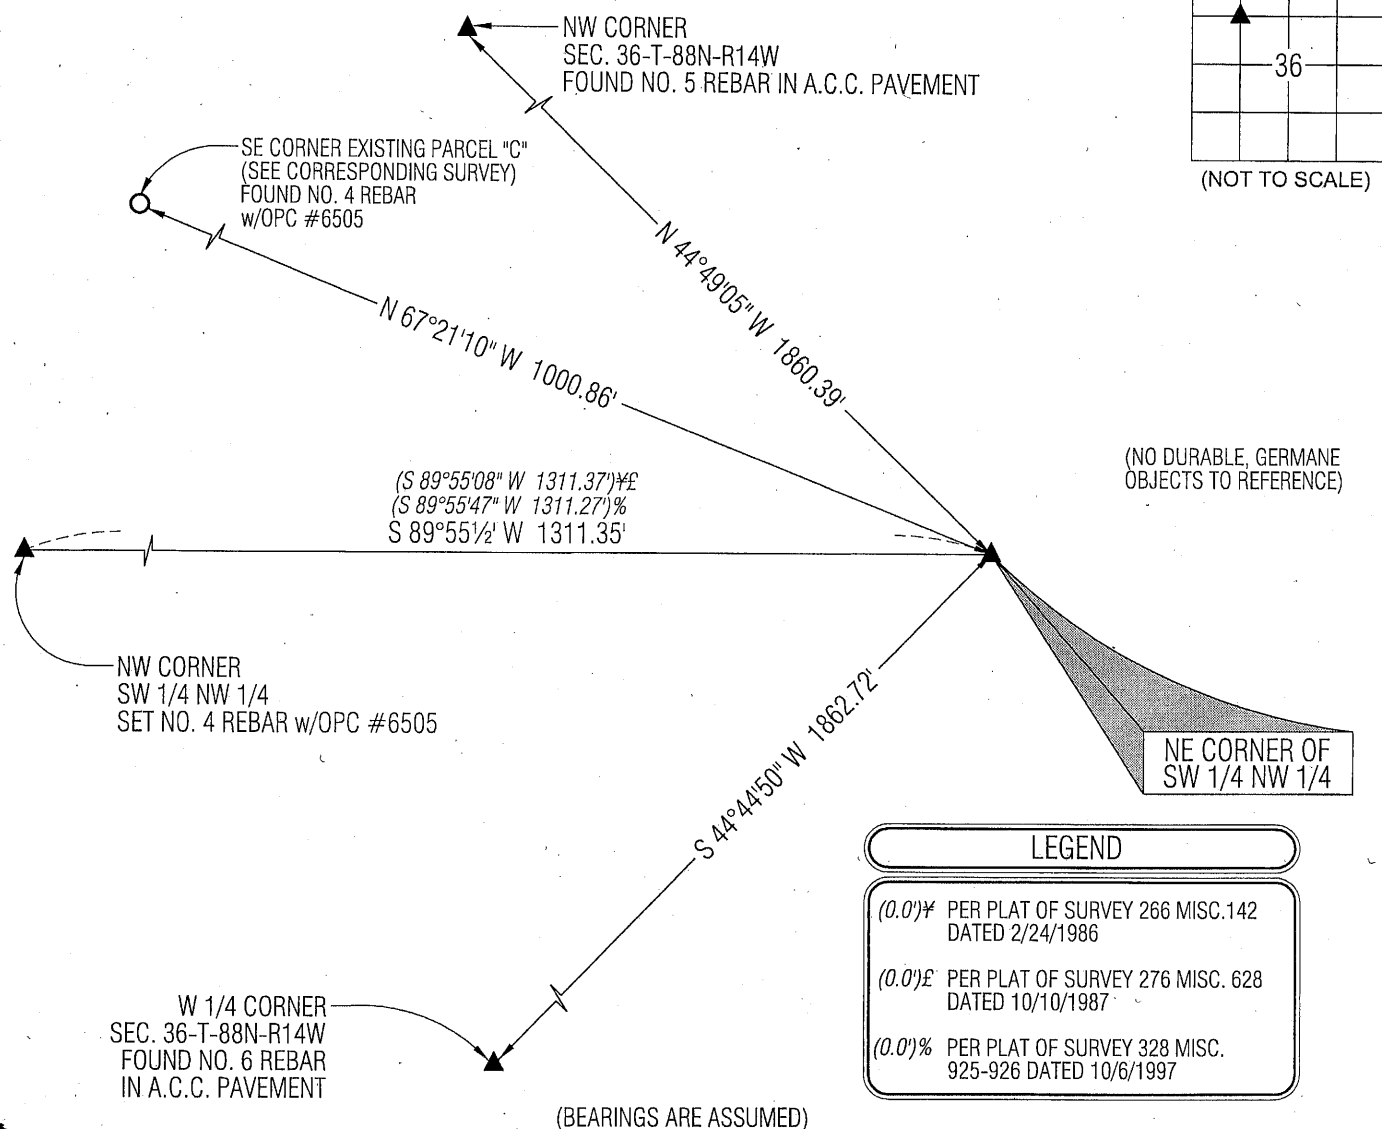

HELLAND ENGINEERING & SURVEYING, LTD.  
1107 Technology Parkway  
Cedar Falls, Iowa 50613-6951  
(319)-266-0161

SHINER = 8D NAIL & 1 5/16"Ø METAL SHINER  
BRASS TAG = 13/16"Ø BRASS TAG  
OPC = PLASTIC CAP (O=ORANGE, R=RED, Y=YELLOW)  
(00)' RECORDED AS FILE NAME: 09-153C3.DWG

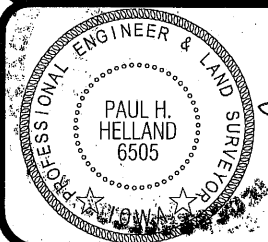

I hereby certify that this land surveying document was prepared  
and the related survey work was performed by me or under my  
direct personal supervision and that I am a duly licensed Land  
Surveyor under the laws of the State of Iowa.

Paul H. Helland  
License Number 6505  
My license renewal date is December 31, 2009.  
All pages or sheets are covered by this seal except:

### LIST CORNERS TO BE INDEXED

| CORNER                  | SECTION | TOWNSHIP | RANGE |
|-------------------------|---------|----------|-------|
| NE CORNER SW 1/4 NW 1/4 | 36      | 88N      | 14W   |
| SE CORNER NW 1/4 NW 1/4 | 36      | 88N      | 14W   |
| SW CORNER NE 1/4 NW 1/4 | 36      | 88N      | 14W   |
| NW CORNER SE 1/4 NE 1/4 | 36      | 88N      | 14W   |