

SC
MISC
INDEX *PE*
MARGIN
PROOF *or*
COMPARE


BLACK HAWK COUNTY IOWA:SS
Filed for record Nov 3, 19 98 at
4:00 P .M. and recorded in Book 332
of MISC Page 164
Kirk D. Eschliman Recorder
FEE 1-5.00/
KIRK ESCHLIMAN
723 BROADWAY ST WATERLOO IA 50703

Kirk D. Eschliman, P.L.S. Iowa Lic. No. 9961, 723 Broadway Street, Waterloo, Iowa 50703 - Phone: 319-234-0509

UNITED STATES PUBLIC LAND SURVEY CORNER CERTIFICATE OF

LAND SURVEY MONUMENTS SITUATED IN SECTION SIX (06), TOWNSHIP 89 NORTH
RANGE 11 WEST, OF THE FIFTH PRINCIPAL MERIDIAN, BLACK HAWK COUNTY, IOWA.
PREVIOUSLY RECORDED IN (NOT PREVIOUSLY RECORDED) (BOOK, PAGE, DOCUMENT NUMBER, ETC.) IN THE COUNTY RECORDER'S OFFICE.

(SHOW REASON FOR PREPARING THIS CERTIFICATE, THE EVIDENCE AND DETAILED PROCEDURES USED IN ESTABLISHING THE CORNER POSITIONS AND MONUMENTATION FOUND OR PLACED.)
MONUMENT DESCRIPTION AND REMARKS: FOUND CONCRETE MONUMENT AS DESCRIBED IN BLACK HAWK COUNTY
FIELD NOTES, DATED: 1939, 2.5 FEET DEEP, SET 1/2" IRON PIN WITH YELLOW IDENTIFICATION CAP, MARKED "IOWA
- 9961" OVER CONCRETE MONUMENT TO SURFACE OF GRANULAR ROADWAY, CURRENTLY THE INTERSECTION OF
EAST BIG ROCK ROAD AND NORTH PILOT GROVE ROAD.

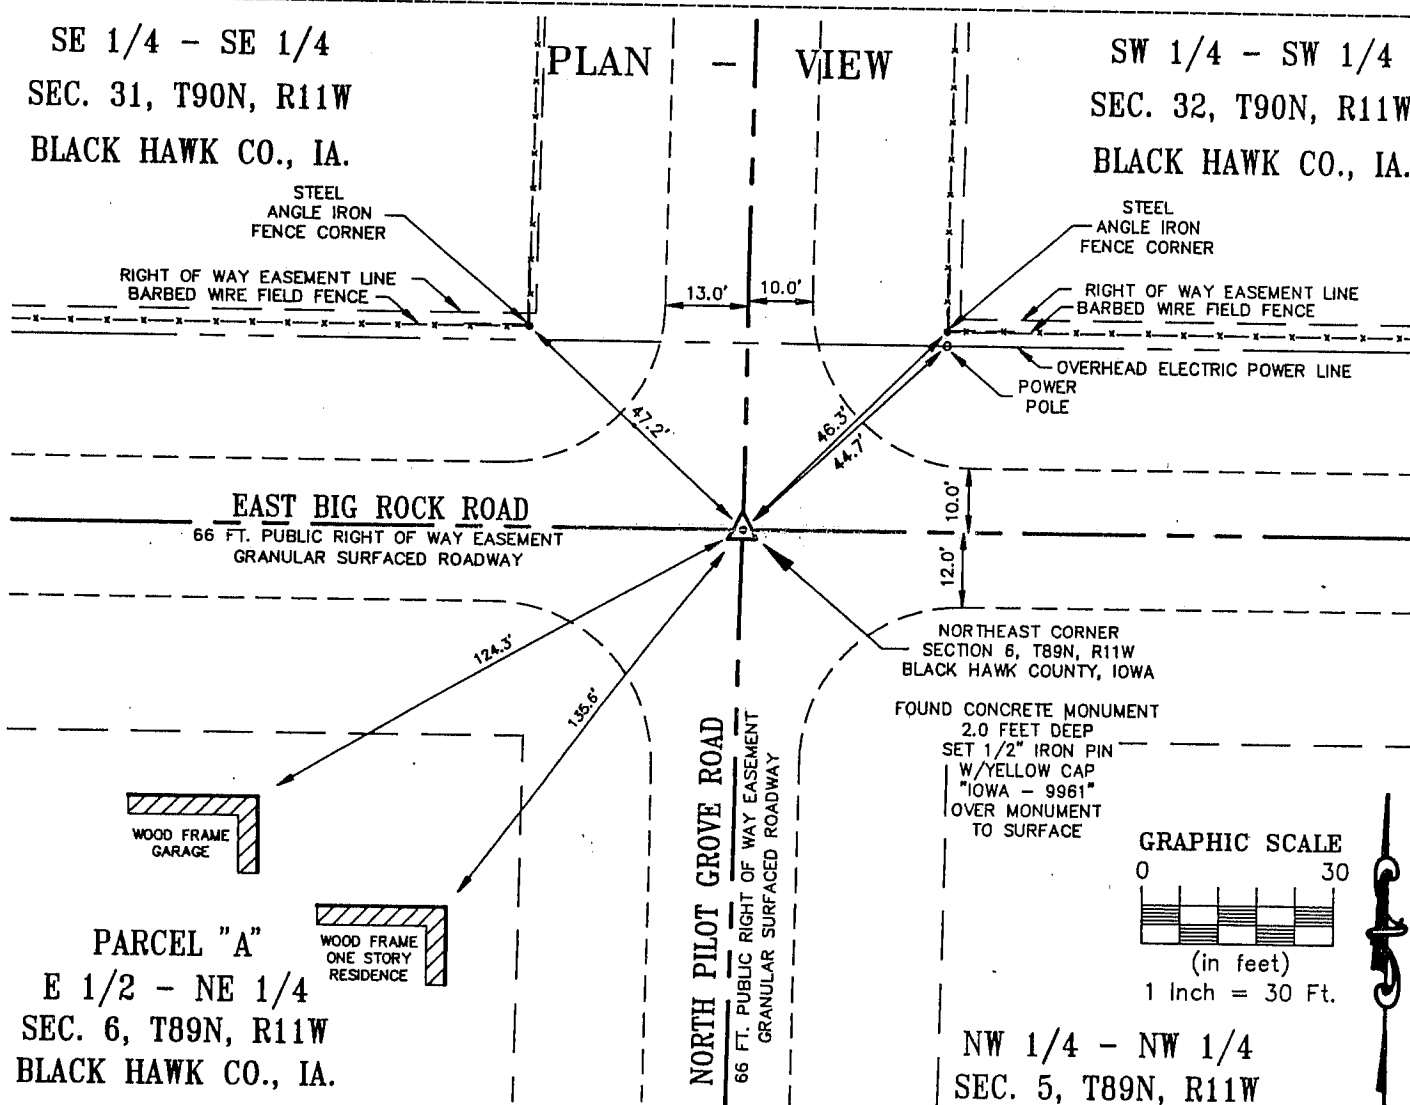

I HEREBY CERTIFY THAT THIS LAND SURVEYING DOCUMENT
WAS PREPARED BY ME OR UNDER MY DIRECT PERSONAL
SUPERVISION AND THAT I AM A DULY LICENSED LAND
SURVEYOR UNDER THE LAWS OF THE STATE OF IOWA.

Kirk D. Eschliman
KIRK D. ESCHLIMAN, P.L.S. IOWA LIC. NO. 9961
MY LICENSE RENEWAL DATE IS DECEMBER 31, 1999
PAGES OR SHEETS COVERED BY THIS SIGNATURE & SEAL: SHEET 1 OF 1

FOR: LEONA A. SCHARES
E 1/2, NE 1/4, SEC. 6, T89N, R11W
BLACK HAWK CO., IA.

REQ. BY: DONNA SCHARES
DUNKERTON, IOWA




KESS & ASSOCIATES, INC.
PROFESSIONAL LAND SURVEYORS : 723 BROADWAY, WATERLOO, IOWA 50703-5813

DRAWN BY: K.D.E. REF.: BK.: PG.:
DATE: 10/31/98 C.A.D.D. FILE: 98815CC3.DWG PROJECT NO.: 98815

List of corners to be indexed:

Corners	Section	Township	Range
NE	06	T89N	R11W

SECTION 06

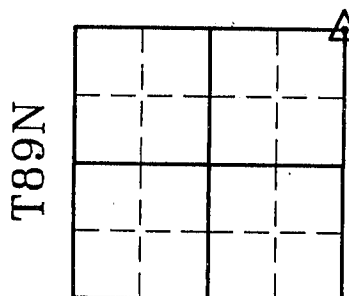

R11W