

UNITED STATES PUBLIC LAND SURVEY CORNER CERTIFICATE

OF

Land Survey Monument situated in Section 6 Township 89 Range 11
of the Fifth Principal Meridian, BLACK HAWK County, Iowa.
Previously recorded in Book _____ Page _____


(Show reason for preparing this certificate, the evidence and detailed procedures used in establishing the corner positions and monuments found or placed.)

Monument Description and Remarks: NEW CORNER: SET 1/2" RE-BAR FROM TIES, 1/2"
FIELD EVIDENCE; W 1/4: SET 1/2" RE-BAR FROM TIES, 1/2" FIELD EVIDENCE


SURVEY DONE SW 1/4 OF NW 1/4

PLAN - VIEW

(Show a minimum of three reference ties to durable physical objects, relevant monuments and physical conditions that will enable recovery of the corner.)

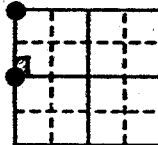


NW CORNER

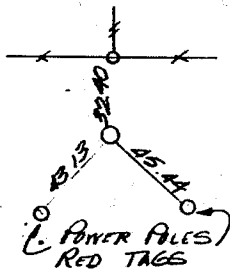

SET PIN FROM TIES, 1/2" FIELD EVIDENCE

W 1/4 CORNER

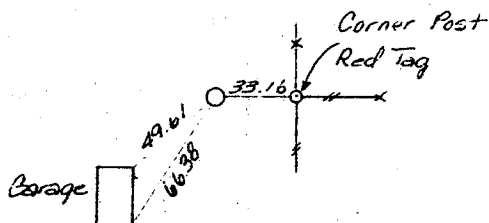

SET PIN FROM TIES, 1/2" FIELD EVIDENCE

I hereby certify that the survey work was completed and this certificate was prepared by me or under my direct personal supervision and that I am a duly registered land surveyor under the laws of the state of Iowa.

Paul H. Helland 9/30/91
REGISTERED LAND SURVEYOR NO. 6505

SEAL



List Corners to be Indexed

Corners	Section	Twp	Range
NW	6	89	11
W 1/4	6	89	11

298 147

298 147

