

PROOF FILED FOR RECORD MAY 13 2005 AT 3:00 P.M. FEE 1-5.00-1.00/

COMPARED

*Patricia A. Less*

BLACK HAWK COUNTY RECORDER

KESS &amp; ASSOCIATES

Kirk D. Eschliman, P.L.S. Iowa Lic. No. 9961, 723 Broadway Street, Waterloo, Iowa 50703 - Phone: 319-234-0509

UNITED STATES PUBLIC LAND SURVEY CORNER CERTIFICATE  
OFLAND SURVEY MONUMENTS SITUATED IN SECTION EIGHT (08), TOWNSHIP EIGHTY-NINE (89) NORTH  
RANGE ELEVEN (11) WEST, OF THE FIFTH PRINCIPAL MERIDIAN, BLACK HAWK COUNTY, IOWA.  
PREVIOUSLY RECORDED IN (NOT PREVIOUSLY RECORDED) (BOOK, PAGE, DOCUMENT NUMBER, ETC.) IN THE COUNTY RECORDER'S OFFICE.

(SHOW REASON FOR PREPARING THIS CERTIFICATE, THE EVIDENCE AND DETAILED PROCEDURES USED IN ESTABLISHING THE CORNER POSITIONS AND MONUMENTATION FOUND OR PLACED.)


MONUMENT DESCRIPTION AND REMARKS:

CURRENT SECTION CORNER CERTIFICATE NOT ON FILE IN THE BLACK HAWK COUNTY ENGINEER'S OFFICE

FOUND NO. 6 REBAR WITHOUT ID. CAP OR FLAGGING, 0.5 FEET BELOW SURFACE OF GRANULAR

SURFACED EAST AIRLINE HIGHWAY.

## PLAN - VIEW

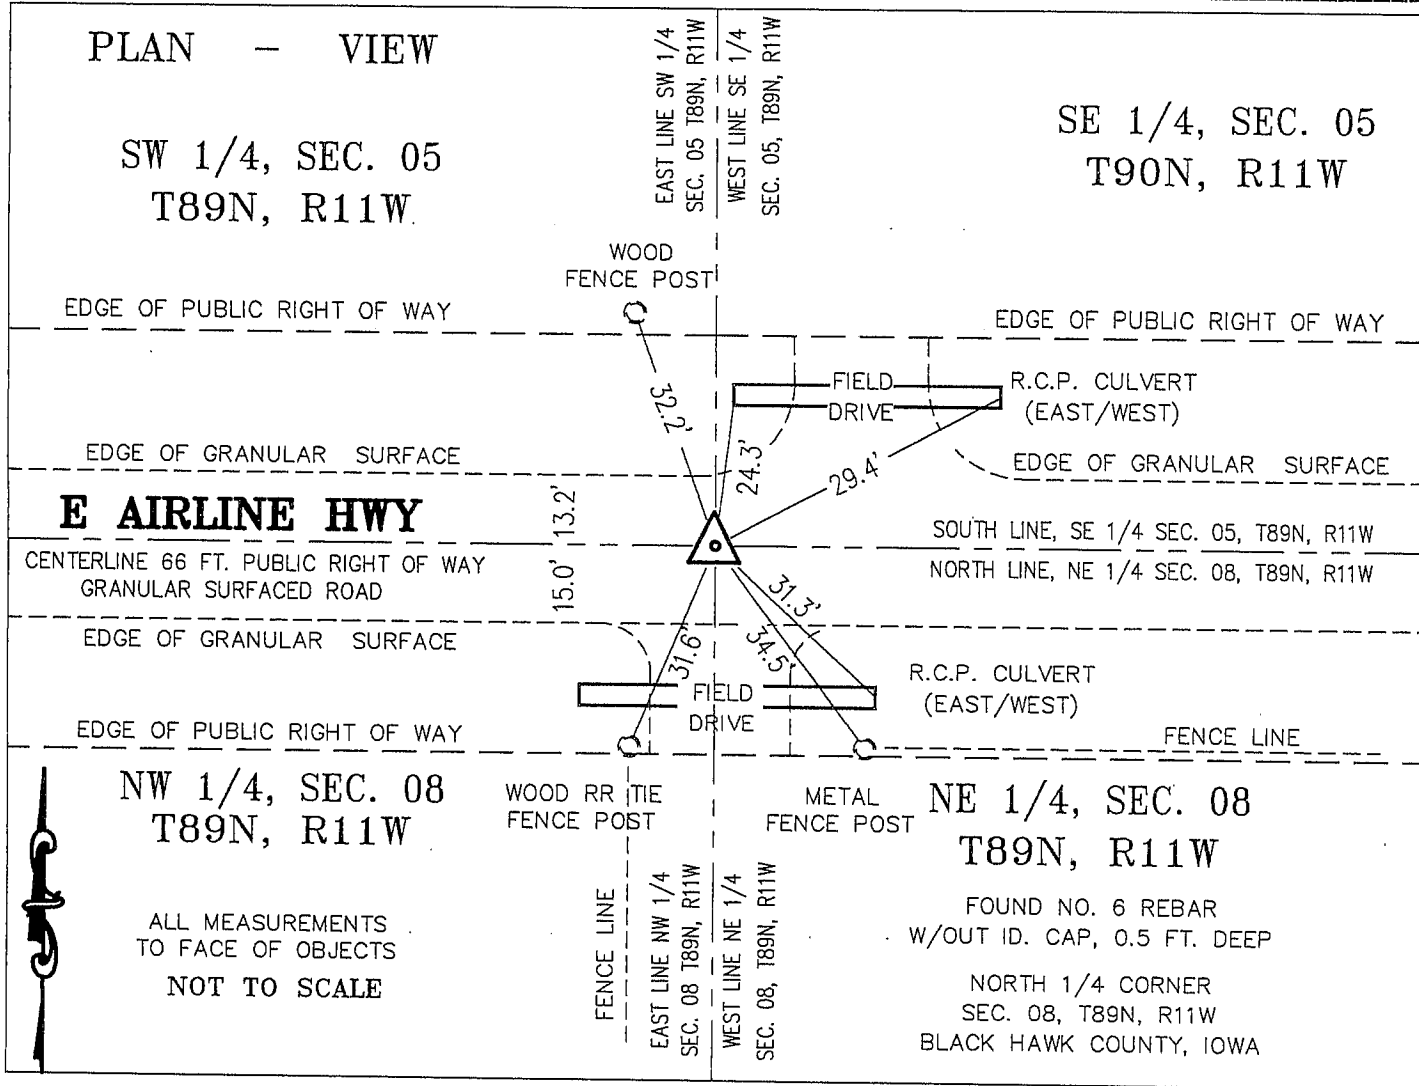SW 1/4, SEC. 05  
T89N, R11WSE 1/4, SEC. 05  
T90N, R11WALL MEASUREMENTS  
TO FACE OF OBJECTS  
NOT TO SCALEI HEREBY CERTIFY THAT THIS LAND SURVEYING DOCUMENT  
WAS PREPARED AND RELATED SURVEY WORK WAS  
WAS PERFORMED BY ME OR UNDER MY DIRECT PERSONAL  
SUPERVISION AND THAT I AM A DULY LICENSED LAND  
SURVEYOR UNDER THE LAWS OF THE STATE OF IOWA.*Kirk D. Eschliman*

DATE: 04/12/2005

KIRK D. ESCHLIMAN, P.L.S. IOWA LIC. NO. 9961  
MY LICENSE RENEWAL DATE IS DECEMBER 31, 2005  
PAGES OR SHEETS COVERED BY THIS SIGNATURE & SEAL: SHEET 1 OF 1FOR: MARK F. & KIM M. ROTTINGHAUS  
3120 N. PILOT GROVE ROAD  
DUNKERTON, IA 50626REQ. BY: MARK F. ROTTINGHAUS  
WATERLOO, IOWA

KESS &amp; ASSOCIATES, INC.


PROFESSIONAL LAND SURVEYORS : 723 BROADWAY, WATERLOO, IOWA 50703-5811

DATE: 04/11/2005 C.A.D.D. FILE: 05A65SCC1.DWG PROJECT NO.: 05A65

## List of corners to be indexed:

Corners	Section	Township	Range
N 1/4 COR.	08	T89N	R11W

R11W

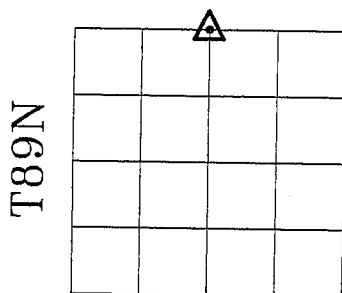

SECTION 08