INDEX | BLACK HAWK COUNTY, IOWA:ss | FEE BOOK # 2005 06843

PROOF | FILED FOR RECORD | SEP 14 | 2004 | AT | 3:00 P. M. | FEE | N/C |

COMPARED | BLACK HAWK COUNTY RECORDER

BLACK HAWK COUNTY ENGINEER

PREPARED BY: BLACK HAWK COUNTY ENGINEERS OFFICE PH.# (319) 833-3008 SLSI 9-94 (219) 833-3139 SLSI 9-94 (219) 833-3139 CERT 12-96


UNITED STATES PUBLIC LAND SURVEY CORNER CERTIFICATE OF Land Survey Monuments situated in Section 13, Township 89 N, Range 11 W, of the Fifth Principal Meridian, BLACK HAWK County, Iowa. Previously recorded in Misc. Book n/a, Page n/a, in County Recorder's Office.

(Show reason for preparing this certificate, the evidence and detailed procedures used in establishing the corner positions and monumentation found or placed.)

Monument Description and Remarks: N.E. 1/16 CORNER, SECTION 13-89-11 CORNER EST. AS PART OF "BARCLAY RD. R.O.W." SURVEY THROUGH N.E. 1/4, AND TO ASSIST WITH 1/16 LINE DETERMINATION FOR CORRECTION TO SURVEY IN MISC. 333-231 FOR PARCEL LOC. N.E. (PLS #8505). SET #5 RBR. x 26"L. w/ 2" DIA. ALUM. CAP IN S. FORESLOPE, ALIGNED w/ FENCE TO SOUTH & 4.5' W. OF "OLD" COR. POST (N. ROW). COR. SET PER STD. 1/4 SECT. DIV.

PLAN - VIEW

(Show a minimum of three reference ties to durable physical objects, relevant monuments and physical conditions that will enable recovery of the corner.)

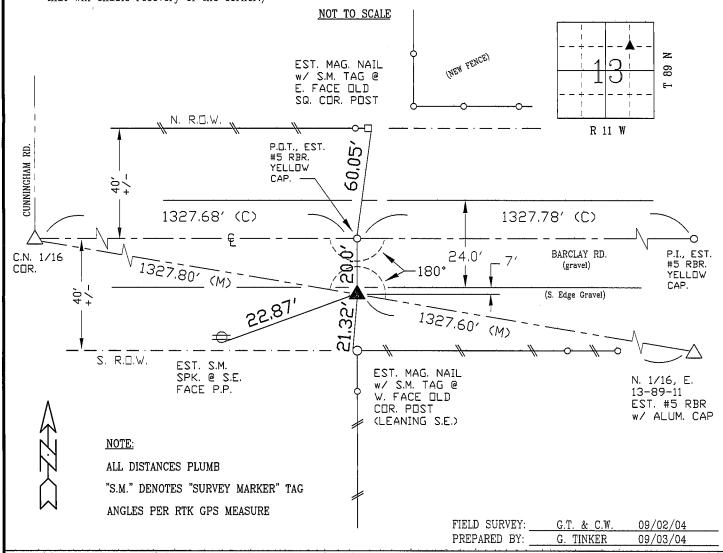

<u>CERTIFICATION</u>

GEOFFRY ALLEN TINKER

15748

I hereby certify that this land surveying document was prepared and the related survey work was performed by me or under my direct personal supervision and that I am a duly licensed Land Surveyor under the laws of the State of Iowa.

Sterffry C Tenter 9/03/04
Geoffry Allen Tigker (date)
License Number 15748

My license renewal date is December 31, 2004

Pages or sheets covered by this seal:

This Land Corner Certificate Only.

LIST CORNERS TO BE INDEXED

| Corner | Section - Township - Range | N.E. 16th | 13 | 89 N | 11 W

09/03/2004 10:43:30 AM, G.T.