
Doc ID: 005264140001 Type: GEN Kind: CORNER Recorded: 08/30/2013 at 02:56:51 PM Fee Amt: \$7.00 Page 1 of 1 Black Hawk County Iowa JUDITH A MCCARTHY RECORDER File 2014-0004830

*Paul H. Helland, 1107 Technology Parkway, Cedar Falls, lowa 50613-6951, (319)-266-0161 UNITED STATES PUBLIC LAND SURVEY CORNER CERTIFICATE OF _, TOWNSHIP NO. LAND SURVEY MONUMENTS SITUATED IN SECTION NO. 15 89 NORTH, RANGE WEST OF THE FIFTH PRINCIPAL MERIDIAN, **BLACK HAWK** 11 COUNTY, IOWA. PREVIOUSLY RECORDED IN N/A (SHOW REASON FOR PREPARING THIS CERTIFICATE, THE EVIDENCE AND DETAILED PROCEDURES USED IN ESTABLISHING THE CORNER POSITIONS AND MONUMENTATION FOUND OR PLACED.) MONUMENT DESCRIPTION AND REMARKS: NO USPLSCC ON FILE. SURVEY COMPLETED IN THE NW 1/4 OF SEC. 15-T89N-R11W. N 1/4 CORNER: WPA CORNER TIES PAGE 42 DATED 5/2/1939 CALLS FOR [FOUND NIGGERHEAD 11"x7"x4" STONE BROKEN. LOWERED EVIDENCE AND SET C.M. ON TOP 12" UNDERGROUND]. WPA CHAINING NOTES PAGE 10 (NO DATE) CALLS FOR [C.M. 2.1 N.R.L.]. FOUND CONCRETE MONUMENT w/BRASS CAP (0.1' DEEP). SET NO. 4 REBAR 0.17' NORTH OF SAID MONUMENT FOR MAGNETIC DETECTION. PLAN VIEW (SHOW A MINIMUM OF THREE REFERENCE TIES TO DURABLE PHYSICAL OBJECTS, RELEVANT MONUMENTS AND PHYSICAL CONDITIONS THAT WILL ENABLE RECOVERY OF THE CORNER.) 15 **LEGEND** PER WPA CORNER TIES PAGE 42 DATED 5/2/1939 (0.0')b (NOT TO SCALE)

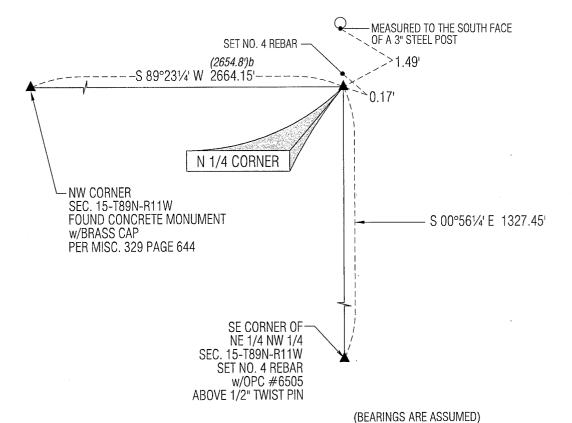


HELLAND ENGINEERING & SURVEYING, LTD.

1107 Technology Parkway Cedar Falls, Iowa 50613-6951 (319)-266-0161

I hereby certify that this land surveying document was prepared and the related survey work was performed by me or under my direct personal supervision and that I am a duly licensed Professional Land-Surveyor under the laws of the State of Iowa.

Paul H. Helland License Number 6505 My license renewal date is December 31, 2013. All pages or sheets are covered by this seal except:

SHINER = 8d NAIL & 1 5/16"Ø METAL SHINER BRASS TAG = 8d NAIL & 13/16"Ø BRASS TAG OPC = PLASTIC CAP (0=ORANGE, R=RED, Y=YELLOW) (00") RECORDED AS FILE NAME: 13-189-28.DWG

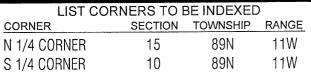

HELLAND 6505 ₾/owA

(7.00) De