

Doc ID: 005064080001 Type: GEN
Kind: CORNER
Recorded: 02/14/2013 at 10:36:55 AM
Fee Amt: \$7.00 Page 1 of 1
Black Hawk County Iowa
JUDITH A MCCARTHY RECORDER
File **2013-00017043**

DANIEL T. CRAWFORD, P.E. & L.S. Crawford Engineering & Surveying, Inc., Independence, Iowa 319/334-7077

UNITED STATES PUBLIC LAND SURVEY CORNER CERTIFICATE

OF

Land Survey Monuments situated in Section 16, Township 89 N, Range 11 W, of the Fifth Principal Meridian, Black Hawk County, Iowa.

Previously recorded in N/A in County Recorder's Office.

Monument Description and Remarks:


Reason for preparing certificate: Current certificate is not on file

Evidence and detailed procedure used to establish corner position: Corner position previously established

Monumentation found or placed: Found Standard Concrete Monument

PLAN-VIEW

(Show a minimum of three reference ties to durable physical objects, relevant monuments and physical conditions that will enable recovery of the corner).

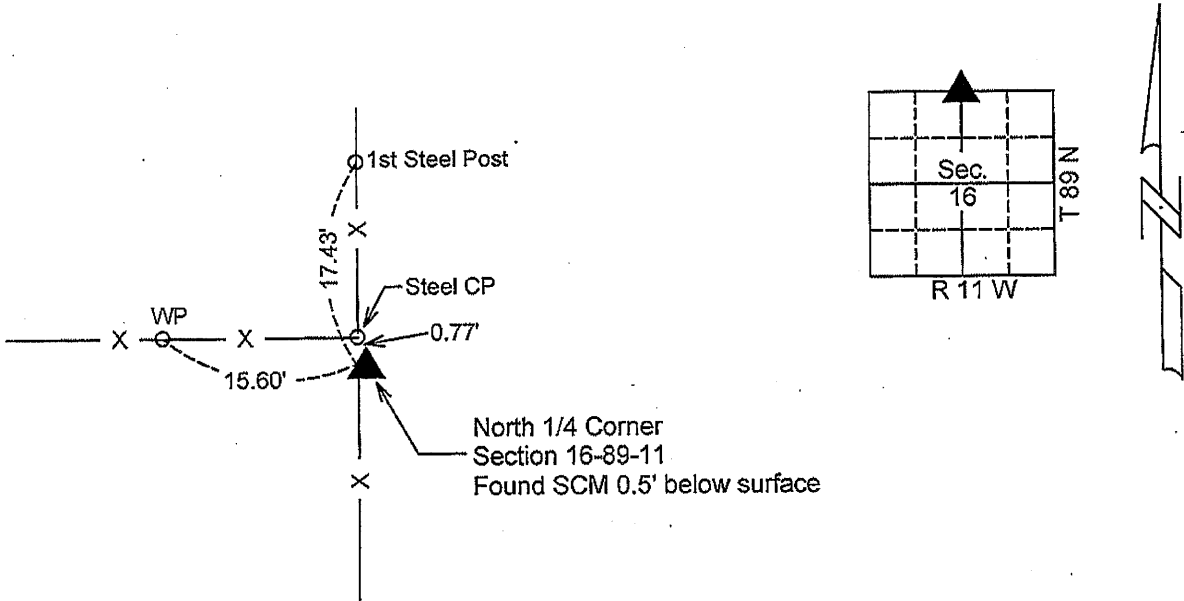

I hereby certify that the survey work was completed and this land surveying document was prepared by me or under my direct personal supervision and that I am a duly licensed land surveyor under the laws of the State of Iowa.

Signature: Daniel T. Crawford
DANIEL T. CRAWFORD, P.E. & L.S.

Date: 1-15-13 Reg. No. 8812

My license renewal date is December 31, 2013

List Corners to be Indexed			
Corners	Section	Twp.	Range
North 1/4 Corner	16	89 N	11 W

SEAL

