

Paul H. Helland, 1107 Technology Parkway, Cedar Falls, Iowa 50613-6951, (319)-266-0161

UNITED STATES PUBLIC LAND SURVEY CORNER CERTIFICATE OF

LAND SURVEY MONUMENTS SITUATED IN SECTION NO. 17, TOWNSHIP NO. 89 NORTH, RANGE NO. 11 WEST OF THE FIFTH PRINCIPAL MERIDIAN, BLACK HAWK COUNTY, IOWA.

PREVIOUSLY RECORDED IN _____

(SHOW REASON FOR PREPARING THIS CERTIFICATE, THE EVIDENCE AND DETAILED PROCEDURES USED IN ESTABLISHING THE CORNER POSITIONS AND MONUMENTATION FOUND OR PLACED.)


MONUMENT DESCRIPTION AND REMARKS:

No corner certificates on file. Survey completed in the SE 1/4 NW 1/4 of Sec. 17-T89N-R11W.

- CENTER: No Black Hawk County Engineer reference ties exist. Surveyor's Record Book 1 Page 79 (small book) in Auditor's Office dated 7/12/1866 calls for "Stone" at corner. Excavated 3'±Ø circle around broken off wood corner post in 1'±Ø P.C.C. base. Also probed for stone from 8' West to 3' East to 4.5' South of said corner post. No stone found. Set No. 4 rebar w/orange plastic cap #6505 at SE corner of said corner post.
- NE CORNER SE 1/4 NW 1/4: No Black Hawk County Engineer reference ties exist. Surveyor's Record Book 1 (big book) Page 118 in the Auditor's Office calls for "Iron Bar" at corner. Found 1/2" square iron twist pin 0.4' deep, top 4" bent NEly, straightened.

PLAN VIEW

(SHOW A MINIMUM OF THREE REFERENCE TIES TO DURABLE PHYSICAL OBJECTS, RELEVANT MONUMENTS AND PHYSICAL CONDITIONS THAT WILL ENABLE RECOVERY OF THE CORNER.)

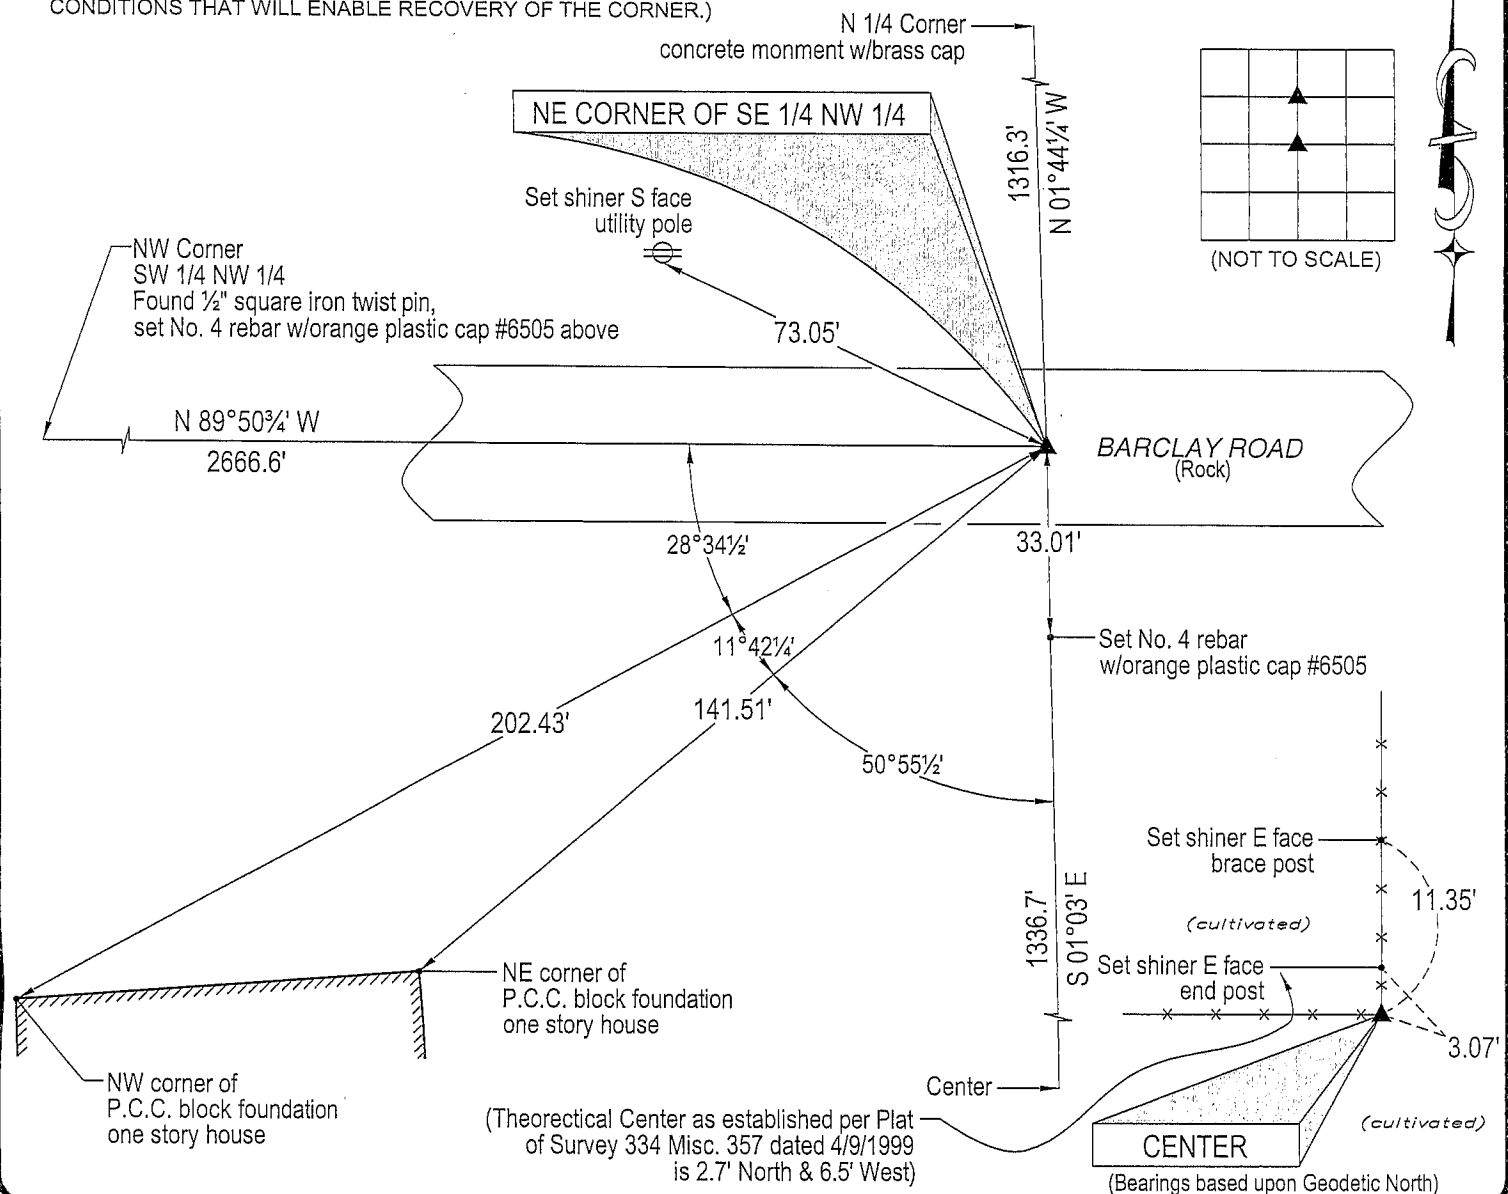


HELLAND ENGINEERING & SURVEYING, LTD.

1107 Technology Parkway
Cedar Falls, Iowa 50613-6951
(319)-266-0161

shiner = 8d nail & 1 15/16"Ø metal shiner

(00') Recorded As

File Name: 05-166c2.dwg

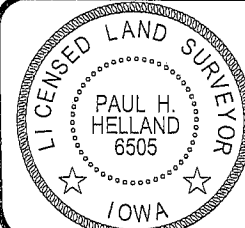

I hereby certify that this land surveying document was prepared and the related survey work was performed by me or under my direct personal supervision and that I am a duly licensed Land Surveyor under the laws of the State of Iowa.

Paul H. Helland 5/4/2005
Paul H. Helland
License Number 6505
My license renewal date is December 31, 2005.
All pages or sheets are covered by this seal except:

LIST CORNERS TO BE INDEXED

| CORNER | SECTION | TOWNSHIP | RANGE |
|----------------------------|---------|----------|-------|
| CENTER | 17 | 89N | 11W |
| NE CORNER SE 1/4 NW 1/4 | 17 | 89N | 11W |

Ran