

UNITED STATES PUBLIC LAND SURVEY CORNER CERTIFICATE
OF


Land Survey Monuments situated in Section 17, Township 89 N, Range 11 W, of the Fifth Principal Meridian, BLACK HAWK County, Iowa.
Previously recorded in _____ in County Recorder's Office.
(book, page, document number, etc.)

(Show reason for preparing this certificate, the evidence and detailed procedures used in establishing the corner positions and monumentation found or placed.)

Monument Description and Remarks: (Corner Certificates currently not on file.)
N. 1/4 Corner - found WPA monument 18" below surface from ref. ties
S. 1/4 Corner - found WPA monument 0.8' below road surface from ref. ties.

PLAN - VIEW

(Show a minimum of three reference ties to durable physical objects, relevant monuments and physical conditions that will enable recovery of the corner.)

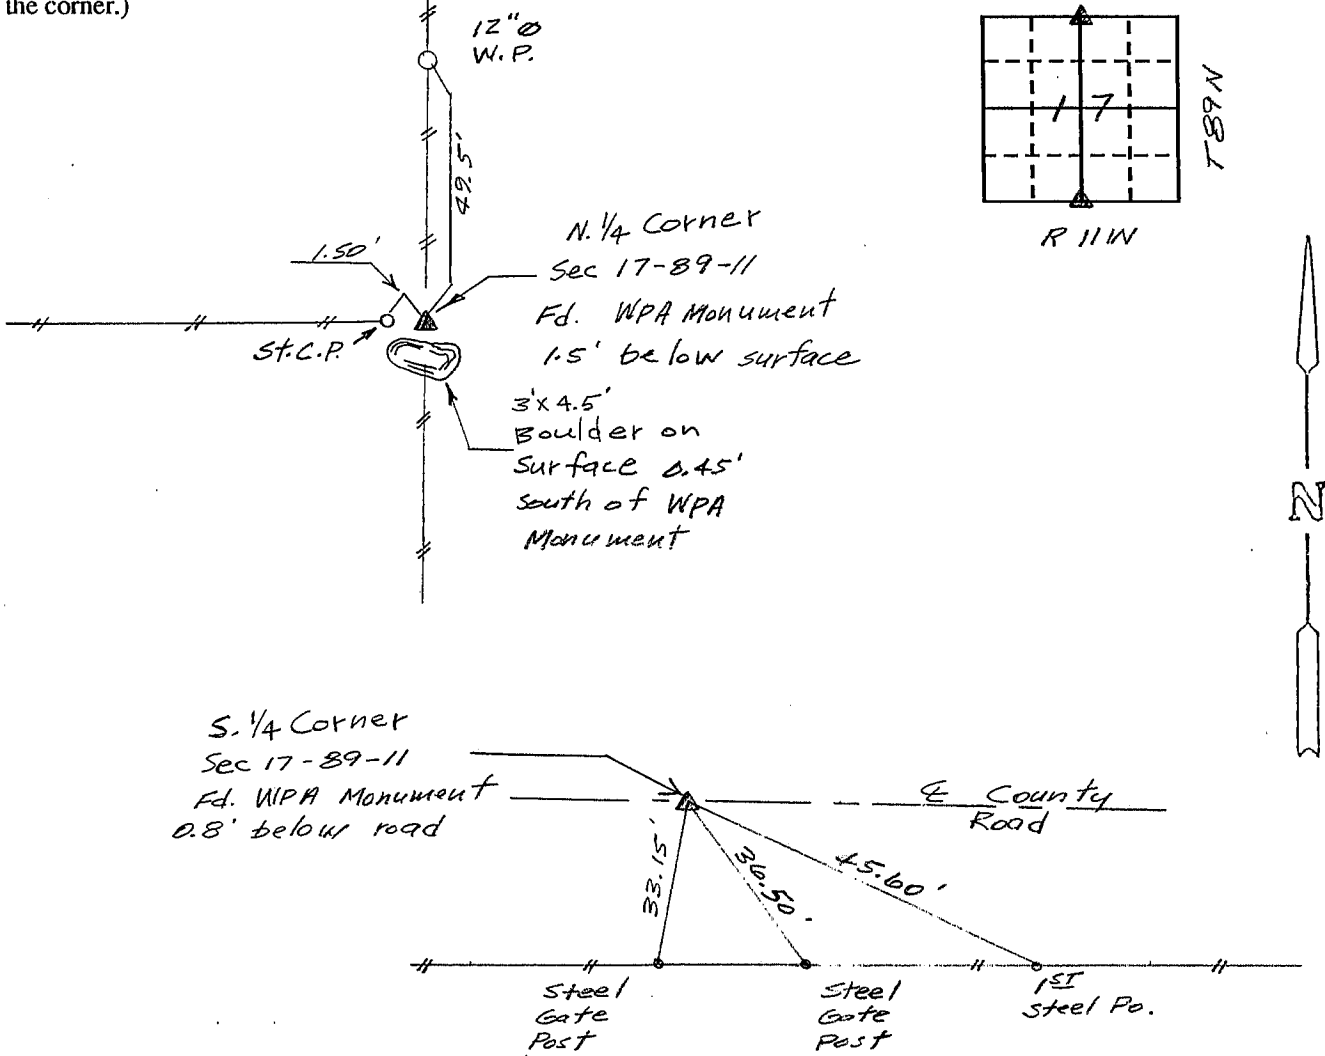


I hereby certify that the survey work was completed and this land surveying document was prepared by me or under my direct personal supervision and that I am a duly registered land surveyor under the laws of the state of Iowa

Signature: Daniel T. Crawford
Name typed or printed: Daniel T. Crawford, L.S.

Date: 4/8/99 Reg. No. 8812

My registration renewal date is December 31, 1999

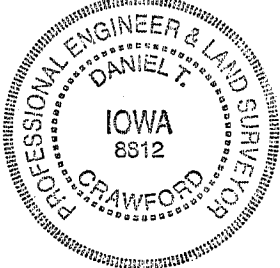

Corners	List Corners to be Indexed		
	Section	Twp	Range
N. 1/4	17	89 N	11 W
S. 1/4	8	89 N	11 W
N. 1/4	20	89 N	11 W
S. 1/4	17	89 N	11 W

2/13/2001

As of above date, this document is "NOT" on record w/ co. recorder.

D.T.