

Reserved for County Recorder's use.

Doc ID: 009362640001 Type: GEN  
Recorded: 08/21/2018 at 01:19:47 PM  
Fee Amt: \$7.00 Page 1 of 1  
Black Hawk County Iowa  
SANDIE L. SMITH RECORDER  
File **2019-00002973**

Kyle J. Helland, 1107 Technology Parkway, Cedar Falls, Iowa 50613-6951, (319)-266-0161

UNITED STATES PUBLIC LAND SURVEY CORNER CERTIFICATE  
OF

LAND SURVEY MONUMENTS SITUATED IN SECTION NO. 18, TOWNSHIP NO. 89 NORTH, RANGE  
NO. 11 WEST OF THE FIFTH PRINCIPAL MERIDIAN, BLACK HAWK COUNTY, IOWA.  
PREVIOUSLY RECORDED IN 332 MISC. 265

(SHOW REASON FOR PREPARING THIS CERTIFICATE, THE EVIDENCE AND DETAILED PROCEDURES USED IN ESTABLISHING THE  
CORNER POSITIONS AND MONUMENTATION FOUND OR PLACED.)


MONUMENT DESCRIPTION AND REMARKS:

ONLY ONE REFERENCE TIE REMAINS. SURVEY COMPLETED IN THE NW FRL 1/4 OF SEC. 18-T89N-R11W.

→ **E 1/4 CORNER:** JOHN BALL HISTORICAL SURVEY PAGE 81 DATED 07/13/1866 CALLS FOR [MOUND]. USPLSCC  
332 MISC. 265 DATED 11/11/1998 CALLS FOR [FD. CONC. MONU. 2" DEEP (TOP BROKEN)]. SERCHED AREA  
FOUND STANDARD CONCRETE MONUMENT (TOP BROKEN) WITH NO. 4 REBAR ON SOUTHEAST CORNER FOR  
MAGNETIC DETECTION. SET A CUT "X" TOP CENTER OF SAID MONUMENT.

PLAN VIEW


(SHOW A MINIMUM OF THREE REFERENCE TIES TO DURABLE PHYSICAL OBJECTS, RELEVANT MONUMENTS AND PHYSICAL  
CONDITIONS THAT WILL ENABLE RECOVERY OF THE CORNER.)

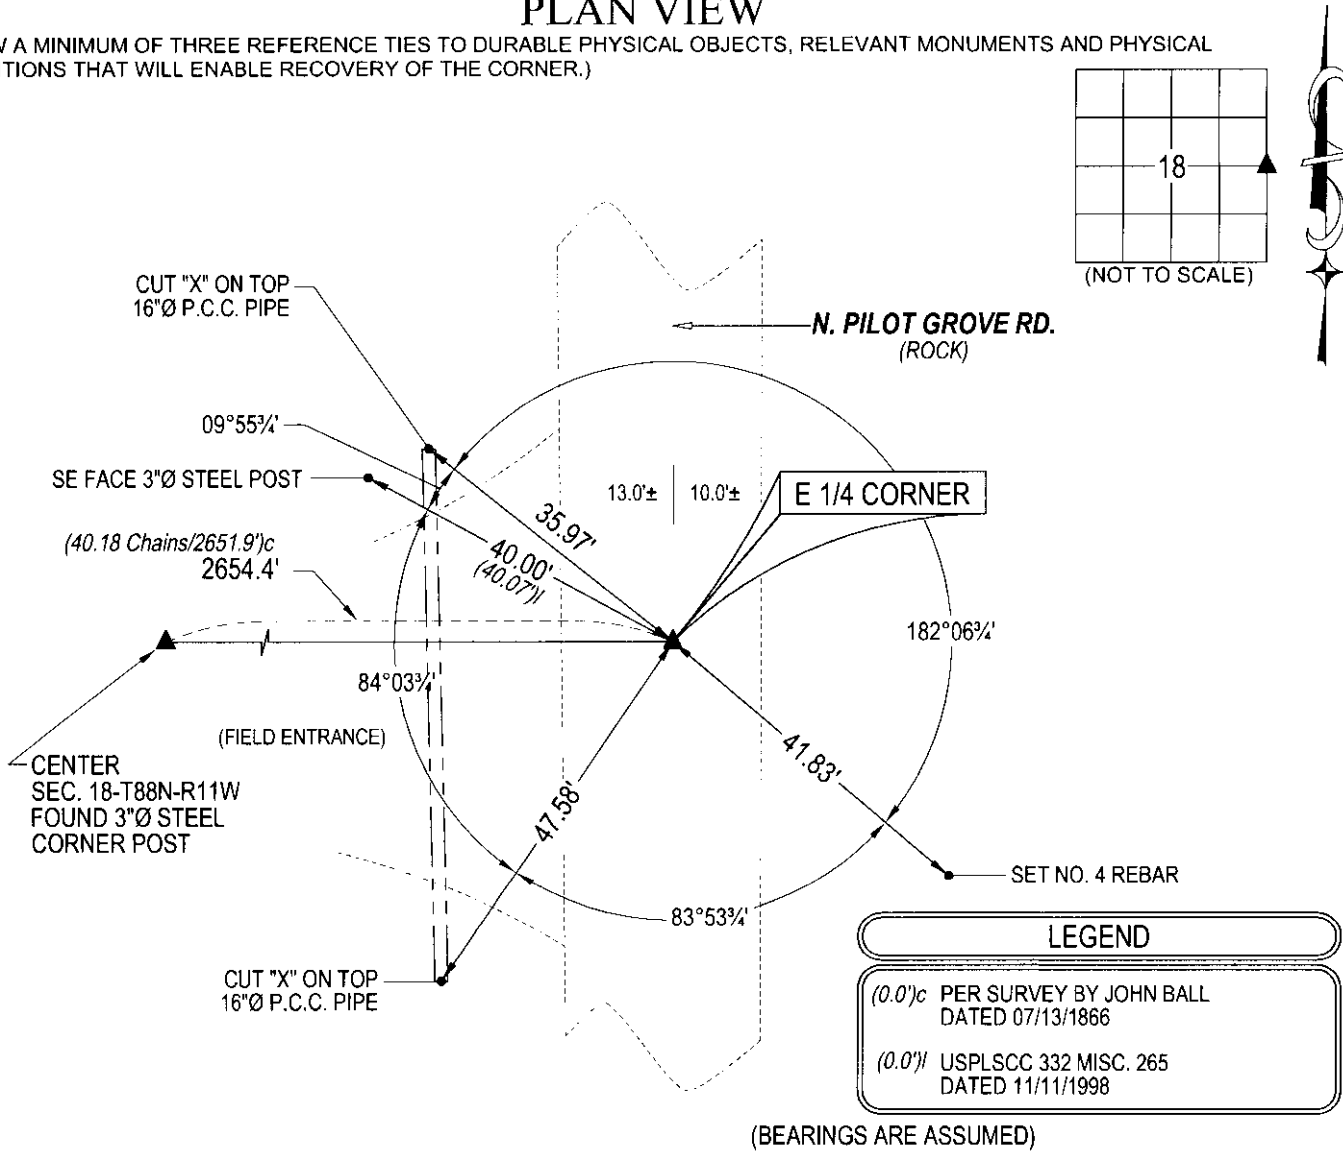



HELLAND ENGINEERING & SURVEYING, LTD.  
1107 Technology Parkway  
Cedar Falls, Iowa 50613-6951  
(319)-266-0161

SHINER = 4d. NAIL & 1 5/16"Ø METAL SHINER  
BRASS TAG = 4d. NAIL & 13/16"Ø BRASS TAG  
OPC = PLASTIC CAP (O=ORANGE, R=RED, Y=YELLOW)  
(00') RECORDED AS  
DRAWN BY: CDR  
FILE NAME: 18-191-22.DWG



I hereby certify that this land surveying document was prepared  
and the related survey work was performed by me or under my  
direct personal supervision and that I am a duly licensed  
Professional Land Surveyor under the laws of the State of Iowa.  
*Kyle J. Helland* 8/13/2018  
Kyle J. Helland  
License Number 23212  
My license renewal date is December 31, 2019.  
All pages or sheets are covered by this seal except:

LIST CORNERS TO BE INDEXED			
CORNER	SECTION	TOWNSHIP	RANGE
E 1/4 CORNER	18	89N	11W
W 1/4 CORNER	17	89N	11W

File Number: 2019-00002973 Seq: