

UNITED STATES PUBLIC LAND SURVEY CORNER CERTIFICATE


Land Survey Monuments situated in Section 18, Township 89N, Range 11W, of the Fifth Principal Meridian, BLACK HAWK County, Iowa.
Previously recorded in N/A in County Recorder's Office.
(book, page, document number, etc.)

(Show reason for preparing this certificate, the evidence and detailed procedures used in establishing the corner positions and monumentation found or placed.)

Monument Description and Remarks DUG 5' X 3' X 2' DEEP HOLE @ CO. TIE LOCATION.
BOTTOM OF HOLE IN APPARENT UNDISTURBED BLACK DIRT, USED PROD ROD IN BOTTOM - HIT NOTHING. USED
COR. TIE TO SOUTH (1939 WPA) STEEL COR POST & PROPORTED E-W DIST 500 OR SEE TO SE COR SECTION PER
WPA NOTES 1939 = 5216.2' ~ 1996 EDM = 5218.04', 1939 500 TO 5'14" = 2563', 1996 = 2563.90'
SET 1/2" X 24" REBAR & CAP 8033 3" DEEP @ 30.70' N OF SO. COR POST & @ 2563.90' EAST OF SW
CORNER.

PLAN - VIEW

(Show a minimum of three reference ties to durable physical objects, relevant monuments and physical conditions that will enable recovery of the corner.)

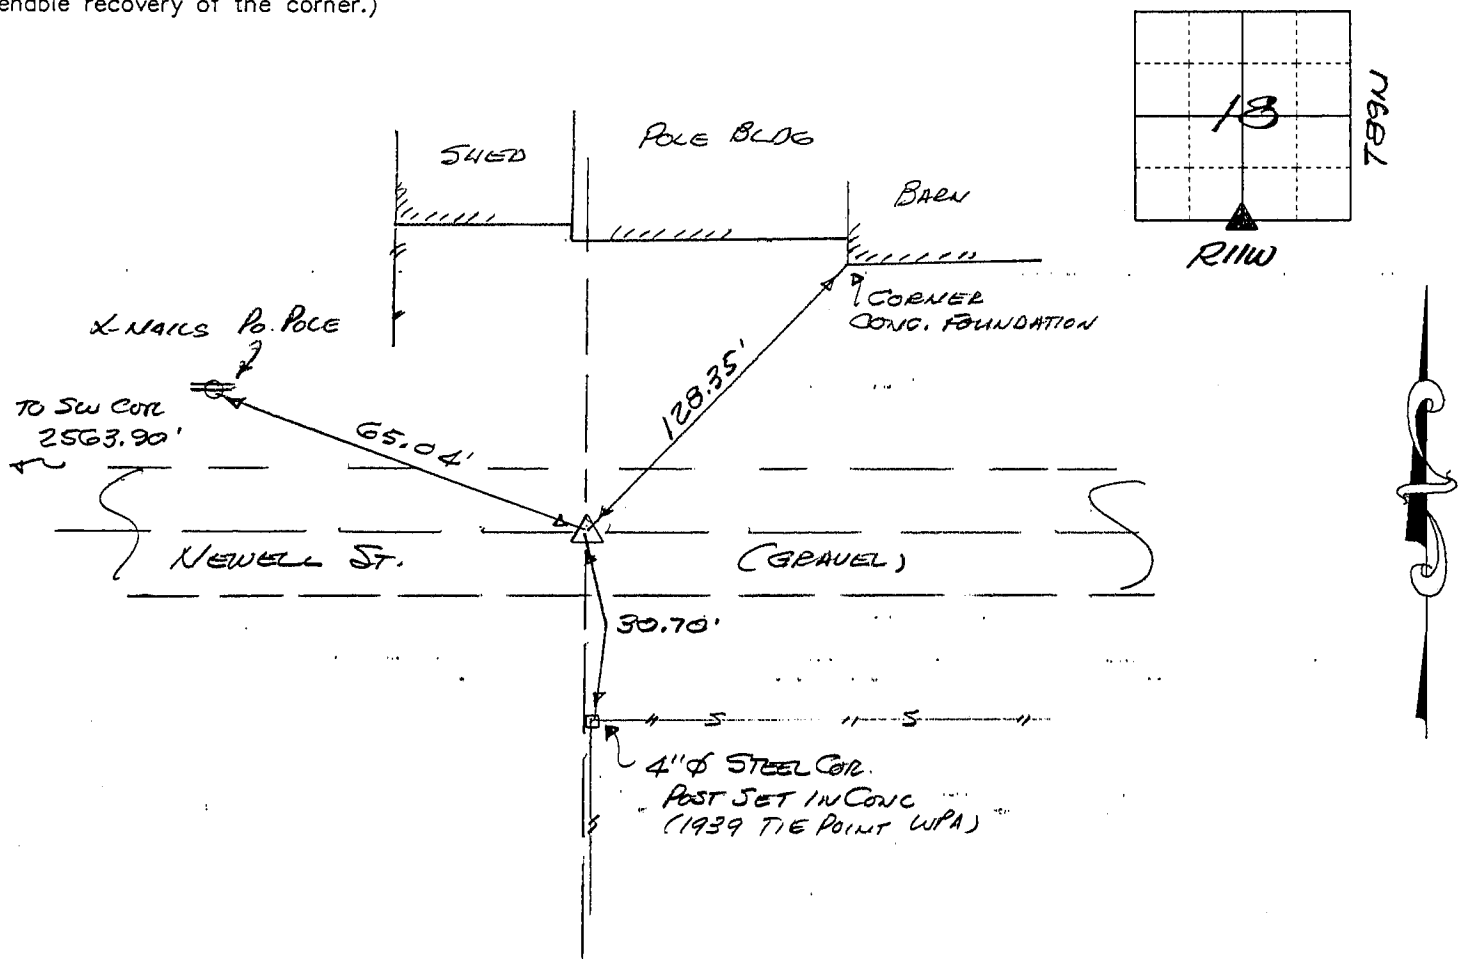


443-45

I hereby certify that the survey work was completed and this certificate was prepared by me or under my direct personal supervision and that I am a duly licensed land surveyor under the laws of the state of Iowa.

Signature: F. William Ring
(Name typed or printed:) F. WILLIAM RING

Date: APR 12, 1996 Lic. No. 8033

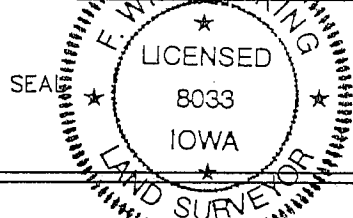

List Corners to be Indexed

Corners	Section	Twp	Range
5'14"	18	89N	11W

Misc. BK. 321 p. 814