

UNITED STATES PUBLIC LAND SURVEY CORNER CERTIFICATE


Land Survey Monuments situated in Section 18, Township 89N, Range 11W, of the Fifth Principal Meridian, BLACK HAWK County, Iowa.
Previously recorded in N/A in County Recorder's Office.
(book, page, document number, etc.)

(Show reason for preparing this certificate, the evidence and detailed procedures used in establishing the corner positions and monumentation found or placed.)

Monument Description and Remarks DUG 5'x 3' HOLE 2' DEEP, BOTTOM OF HOLE IN APPARENT UNDISTURBED BLACK DIRT, USED PROD ROD IN BOTTOM - HIT NOTHING. THIS LOCATION PER 2 REMAINING COA TIES. SET "2"x24" REBAR & CAP 8033, 3" DEEP IN GRAVEL USING 2 OLD TIES FROM NORTH (2"Ø STEEL GATE POST & 2"Ø COR. POST, 1919 TIES).

PLAN - VIEW

(Show a minimum of three reference ties to durable physical objects, relevant monuments and physical conditions that will enable recovery of the corner.)

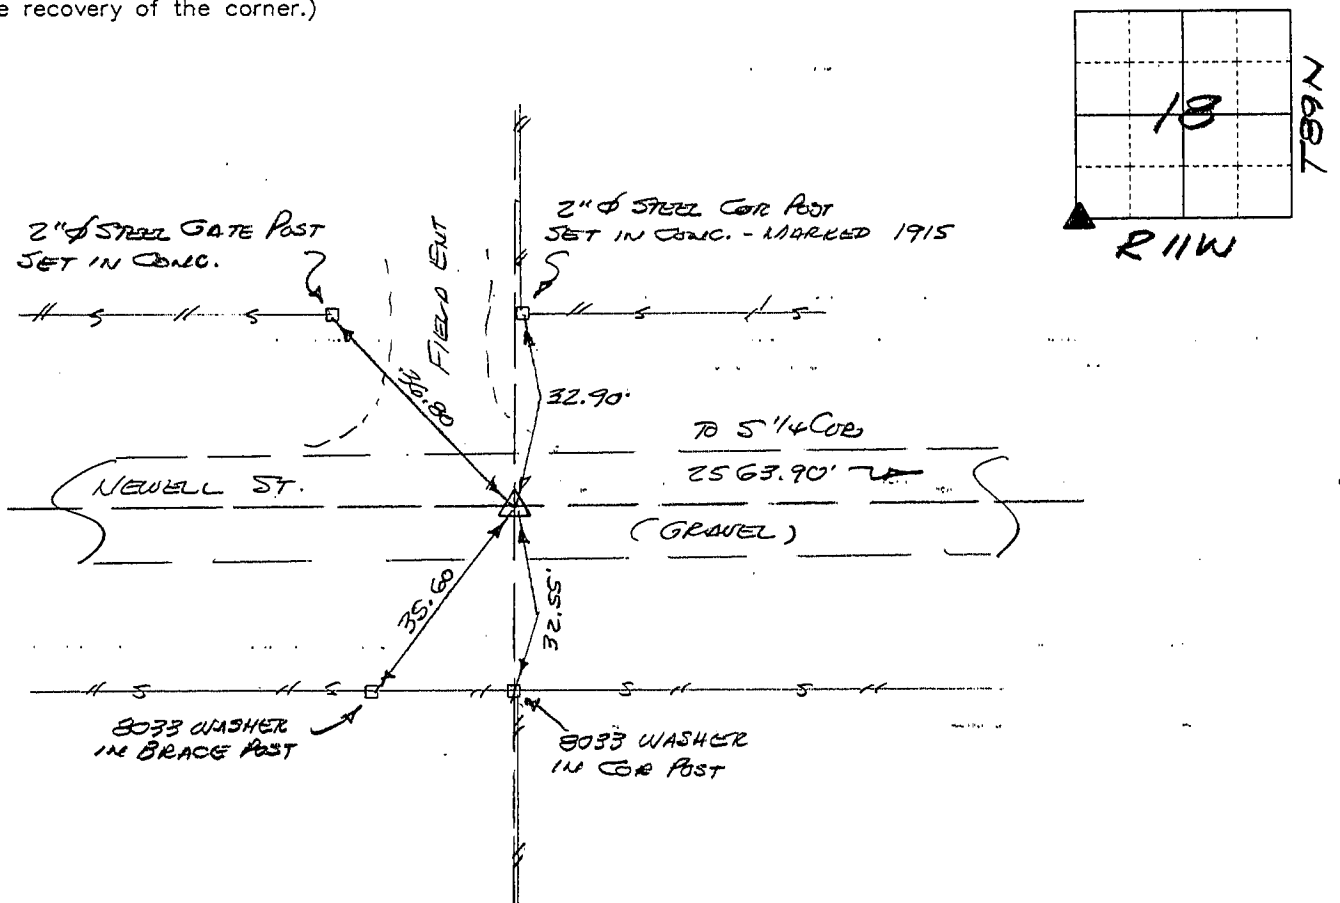


443-45

I hereby certify that the survey work was completed and this certificate was prepared by me or under my direct personal supervision and that I am a duly licensed land surveyor under the laws of the state of Iowa.

Signature: F. William King
(Name typed or printed:) F. William King
Date: NOV 21 1996 Lic. No. 8033

SEA

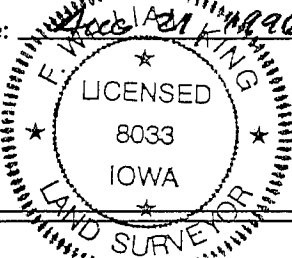

List Corners to be Indexed

Corners	Section	Twp	Range
SW	18	89N	11W

MISC. BK. 321 p. 815