

UNITED STATES PUBLIC LAND SURVEY CORNER CERTIFICATE

OF

Land Survey Monuments situated in Section 22, Township 89 North, Range 11 West, of the Fifth Principal Meridian, Black Hawk County, Iowa.
 Previously recorded in no current references on file in County Recorder's Office.

(Show reason for preparing this certificate, the evidence and detailed procedures used in establishing the corner positions and monuments found or placed.)


Monument Description and Remarks:

NE Corner - Found 3/4" Iron Pipe 0.8 feet deep

N 1/4 Corner - No indication of monument in roadway. Found NW Corner and NE Corner of Section 22 and set point midway and on line.


PLAN - VIEW

(Show a minimum of three reference ties to durable physical objects, relevant monuments and physical conditions that will enable recovery of the corner.)

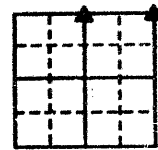


SEE Update
PLS #16264
04/15/08

J.T.

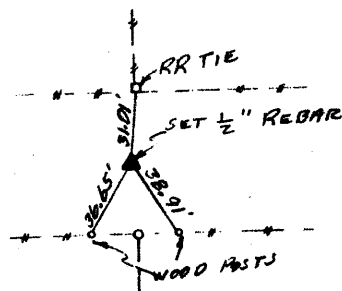

N 1/4 Corner

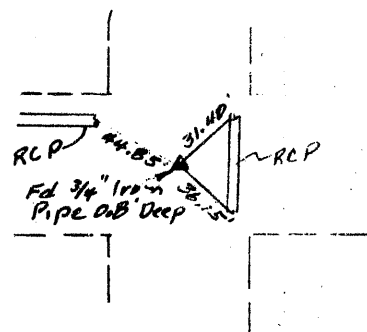

NE Corner

I hereby certify that the survey work was completed and this certificate was prepared by me or under my direct personal supervision and that I am a duly registered land surveyor under the laws of the state of Iowa.

Signature: John R. Crawford
 Name typed or printed: JOHN R. CRAWFORD, L.S.

Date: 6/26/93 Reg. No. 2474



SEAL

Corners	List Corners to be Indexed Section	Twp	Range
NE Corner	22	89	11
N 1/4 Corner	22	89	11

387-243