

UNITED STATES PUBLIC LAND SURVEY CORNER CERTIFICATE

OF

Land Survey Monuments situated in Section 25, Township 89 North, Range 11 West, of the Fifth Principal Meridian, Black Hawk County, Iowa.
Previously recorded in no current records available in County Recorder's Office.


(Show reason for preparing this certificate, the evidence and detailed procedures used in establishing the corner positions and monumentation found or placed.)

Monument Description and Remarks: Found P-K nails in ACC Pavement for references
obtained at County Engineers Office

1/2 mile = 2,641.24 feet

PLAN - VIEW

(Show a minimum of three reference ties to durable physical objects, relevant monuments and physical conditions that will enable recovery of the corner.)

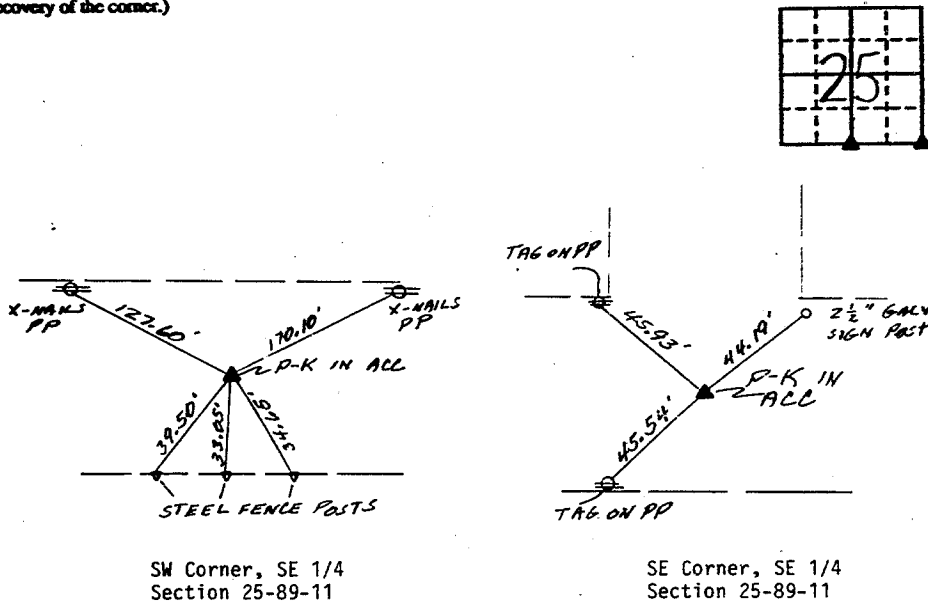


I hereby certify that the survey work was completed and this certificate was prepared by me or under my direct personal supervision and that I am a duly registered land surveyor under the laws of the state of Iowa.

Signature: John R. Crawford
Name typed or printed: John R. Crawford, R.L.S.

Date: 1/13/91 Reg. No. 7474

SEAL

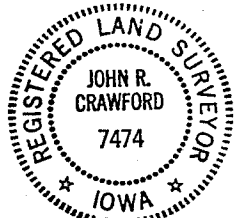

Corners	List Corners to be Indexed		
	Section	Twp	Range
SW Corner SE 1/4	25	89	11
SE Corner SE 1/4	25	89	11