

PREPARED BY / RETURN TO: KENNETH D. STARK IOWA DEPARTMENT OF TRANSPORTATION 1420 4th ST. SE MASON CITY, IA 50401 641-423-7584

ENV UNITED STATES PUBLIC LAND SURVEY CORNER CERTIFICATE

OF

Land Survey Monuments situated in Section 29, Township 89N, Range 11W
of the Fifth Principal Meridian, BLACK HAWK County, Iowa.

Previously recorded in File No. 2012-00001172 in County Recorder's Office.
(book, page, document number, etc.)


(Show reason for preparing this certificate, the evidence and detailed procedures used in establishing the corner positions and monumentation found or placed.)

Monument Description and Remarks: N¹/₄ CORNER: Replaced previously found Alum cap #19957 with a Survey Mark Nail/IDOT Sec. Cor. washer #10898 on \oslash IA. 281 using previous cert of record File No. 2012-00001172 after HMA resurfacing project. Reason for cert: Monumentation and ties have changed and updating IDOT records.

NW CORNER NE¹/₄ NE¹/₄: Replaced previously found Survey Mark Nail with a Survey Mark Nail /IDOT Sec. Cor. washer #10898, 1.1+/- South of \oslash IA. 281 using previous cert of record File No. 2012-00001172 after HMA resurfacing project. Reason for cert: Monumentation and ties have changed and updating IDOT records.

PLAN - VIEW

(Show a minimum of three reference ties to durable physical objects, relevant monuments and physical conditions that will enable recovery of the corner.)

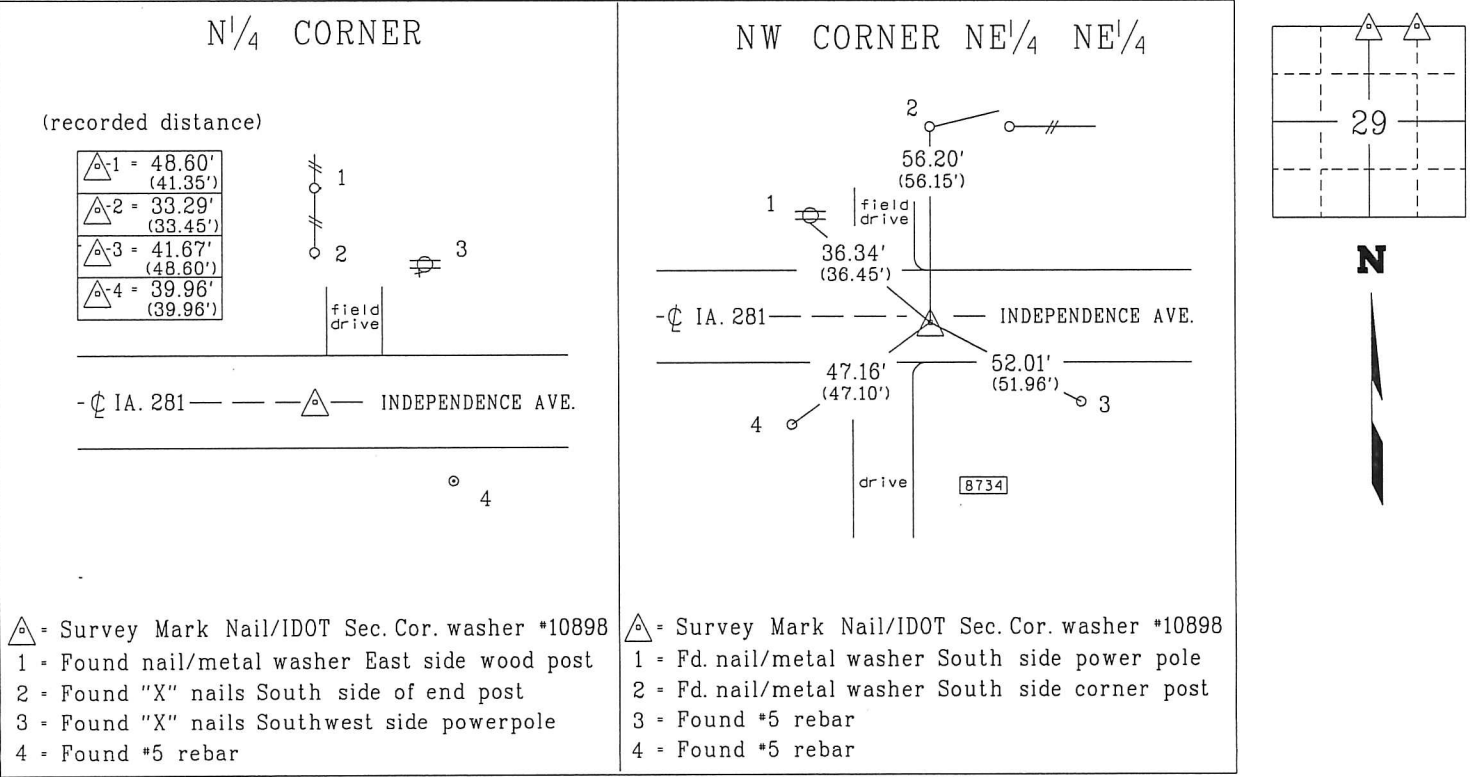

PROFESSIONAL LAND SURVEYOR
KENNETH D. STARK
10898
IOWA

I hereby certify that this land surveying document was prepared and the related survey work was performed by me or under my personal supervision and that I am duly licensed Land Surveyor under the laws of the state of Iowa.

Kenneth D. Stark 06-30-15
Kenneth D. Stark Date
License number 10898
My License renewal date is December 31, 2015
Pages or sheets covered by this seal. 1

List Corners to be Indexed			
Corner	Section	Township	Range
N ¹ / ₄ CORNER	29	89N	11W
NW CORNER NE ¹ / ₄ NE ¹ / ₄	29	89N	11W

drawn by: c/s 3/13