

I
P
Z

Document Number: 2008016233
 Date: Feb 20, 2008 4:30:00 pm
 Aud Fee: 0.00 Rec Fee: 5.00
 Trans Tax: 0.00 Rec Management Fee: 1.00
 E-Com Fee: 1.00 Non-Standard Page Fee: 0.00
 Filed for record in Black Hawk County, Iowa
 Judith A. McCarthy, County Recorder

Kirk D. Eschliman, P.L.S. Iowa Lic. No. 9961, 723 Broadway Street, Waterloo, Iowa 50703 - Phone: 319-234-0509


UNITED STATES PUBLIC LAND SURVEY CORNER CERTIFICATE OF

LAND SURVEY MONUMENTS SITUATED IN SECTION 30, TOWNSHIP 89 NORTH, RANGE 11 WEST, OF THE FIFTH PRINCIPAL MERIDIAN, BLACK HAWK COUNTY, IOWA. NOT PREVIOUSLY RECORDED.

(SHOW REASON FOR PREPARING THIS CERTIFICATE, THE EVIDENCE AND DETAILED PROCEDURES USED IN ESTABLISHING THE CORNER POSITIONS AND MONUMENTATION FOUND OR PLACED.)

MONUMENT DESCRIPTION AND REMARKS:

FOUND 2.0 INCH IRON PIPE, 1.7 FEET BELOW GRANULAR SURFACE OF SOUTH PILOT GROVE ROAD. SET NO. 5 REBAR WITH 2.0 INCH ALUMINUM CAP, 0.3 FEET BELOW GRANULAR SURFACE, ABOVE FOUND PIPE. MONUMENT TIES NOT PREVIOUSLY RECORDED. MONUMENT USED IN A SURVEY IN THE SW 1/4 OF SECTION 30.

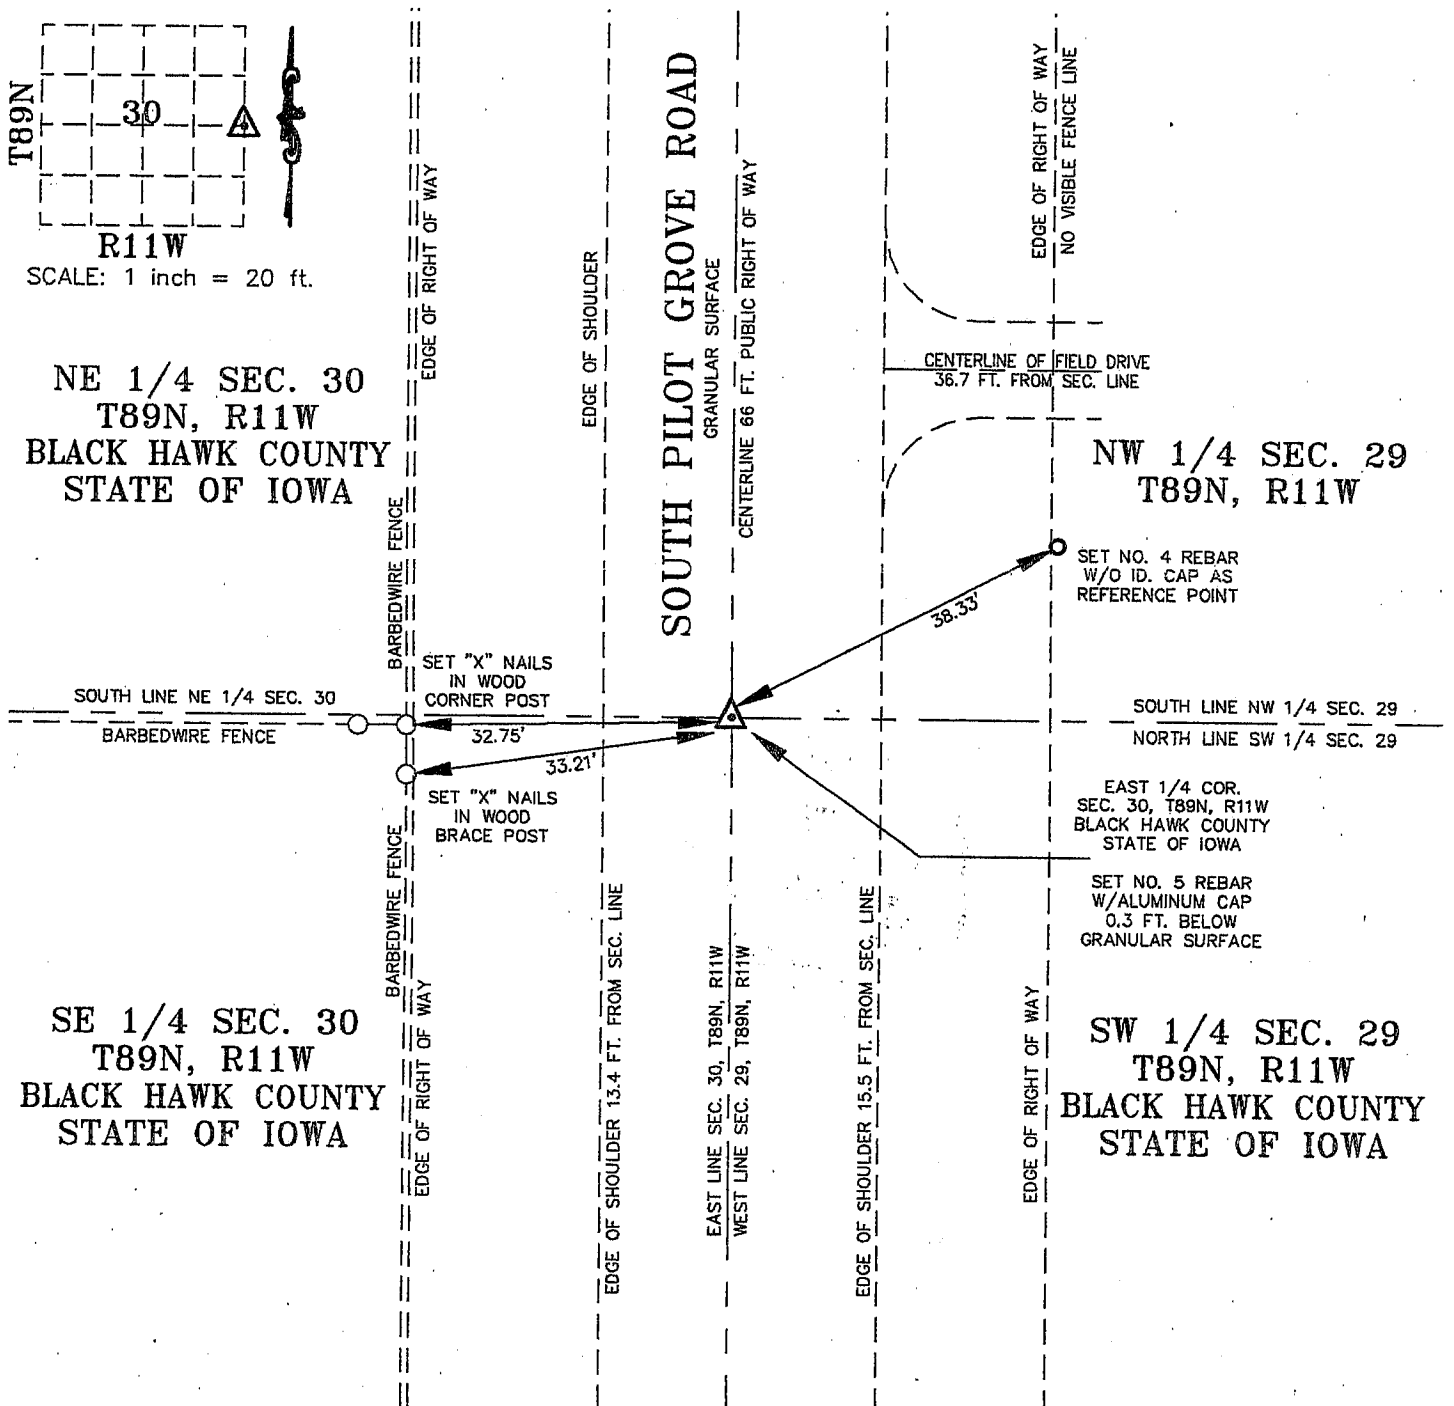

I HEREBY CERTIFY THAT THIS LAND SURVEYING DOCUMENT WAS PREPARED AND THE RELATED SURVEY WORK WAS PERFORMED BY ME OR UNDER MY DIRECT PERSONAL SUPERVISION AND THAT I AM A DULY LICENSED LAND SURVEYOR UNDER THE LAWS OF THE STATE OF IOWA.

Kirk D. Eschliman
 DATE: 02/07/2008
 KIRK D. ESCHLIMAN, P.L.S. IOWA LIC. NO. 9961
 MY LICENSE RENEWAL DATE IS DECEMBER 31, 2009
 PAGES OR SHEETS COVERED BY THIS SIGNATURE & SEAL: SHEET 1 OF 1



LIST OF CORNERS TO BE INDEXED:

CORNER	SEC.	TWP	RANGE
E 1/4	30	89N	11W

KESS & ASSOCIATES, INC.
 723 BROADWAY, WATERLOO, IOWA 50703-5811 PHONE: (319) 234-0509

DATE OF FIELD WORK: 02/05/2008
 DWG. DATE: 02/07/2008 DRAWN BY: BJYK
 CADD FILE: 08A03SCC1.DWG PROJECT NO.: 08A03