

I  
P  
Z


Document Number: 2007020177  
 Date: Mar 28, 2007 4:30:00 pm  
 Aud Fee: 0.00 Rec Fee: 5.00  
 Trans Tax: 0.00 Rec Management Fee: 1.00  
 E-Com Fee: 1.00 Non-Standard Page Fee: 0.00  
 Filed for record in Black Hawk County, Iowa  
 Judith A. McCarthy, County Recorder

Kirk D. Eschliman, P.L.S. Iowa Lic. No. 9961, 723 Broadway Street, Waterloo, Iowa 50703 - Phone: 319-234-0509

# UNITED STATES PUBLIC LAND SURVEY CORNER CERTIFICATE OF LAND SURVEY MONUMENTS SITUATED IN SECTION 30, TOWNSHIP 89 NORTH, RANGE 11 WEST, OF THE FIFTH PRINCIPAL MERIDIAN, BLACK HAWK COUNTY, IOWA. NOT PREVIOUSLY RECORDED.

(SHOW REASON FOR PREPARING THIS CERTIFICATE, THE EVIDENCE AND DETAILED PROCEDURES USED IN ESTABLISHING THE CORNER POSITIONS AND MONUMENTATION FOUND OR PLACED.)

MONUMENT DESCRIPTION AND REMARKS:  
 CURRENT SECTION CORNER CERTIFICATE NOT ON FILE IN THE BLACK HAWK COUNTY RECORDER'S OFFICE.  
 PREVIOUSLY REFERENCED MONUMENTATION WAS DESTROYED DURING PAVEMENT RESURFACING. MONUMENT WAS  
 REESTABLISHED USING SURVEY NOTES AND EXISTING SURVEY MONUMENTATION. SET NO. 5 REBAR WITH 2"  
 ALUMINUM CAP. MONUMENT USED IN FIELD SURVEY IN SW 1/4 SECTION 19.

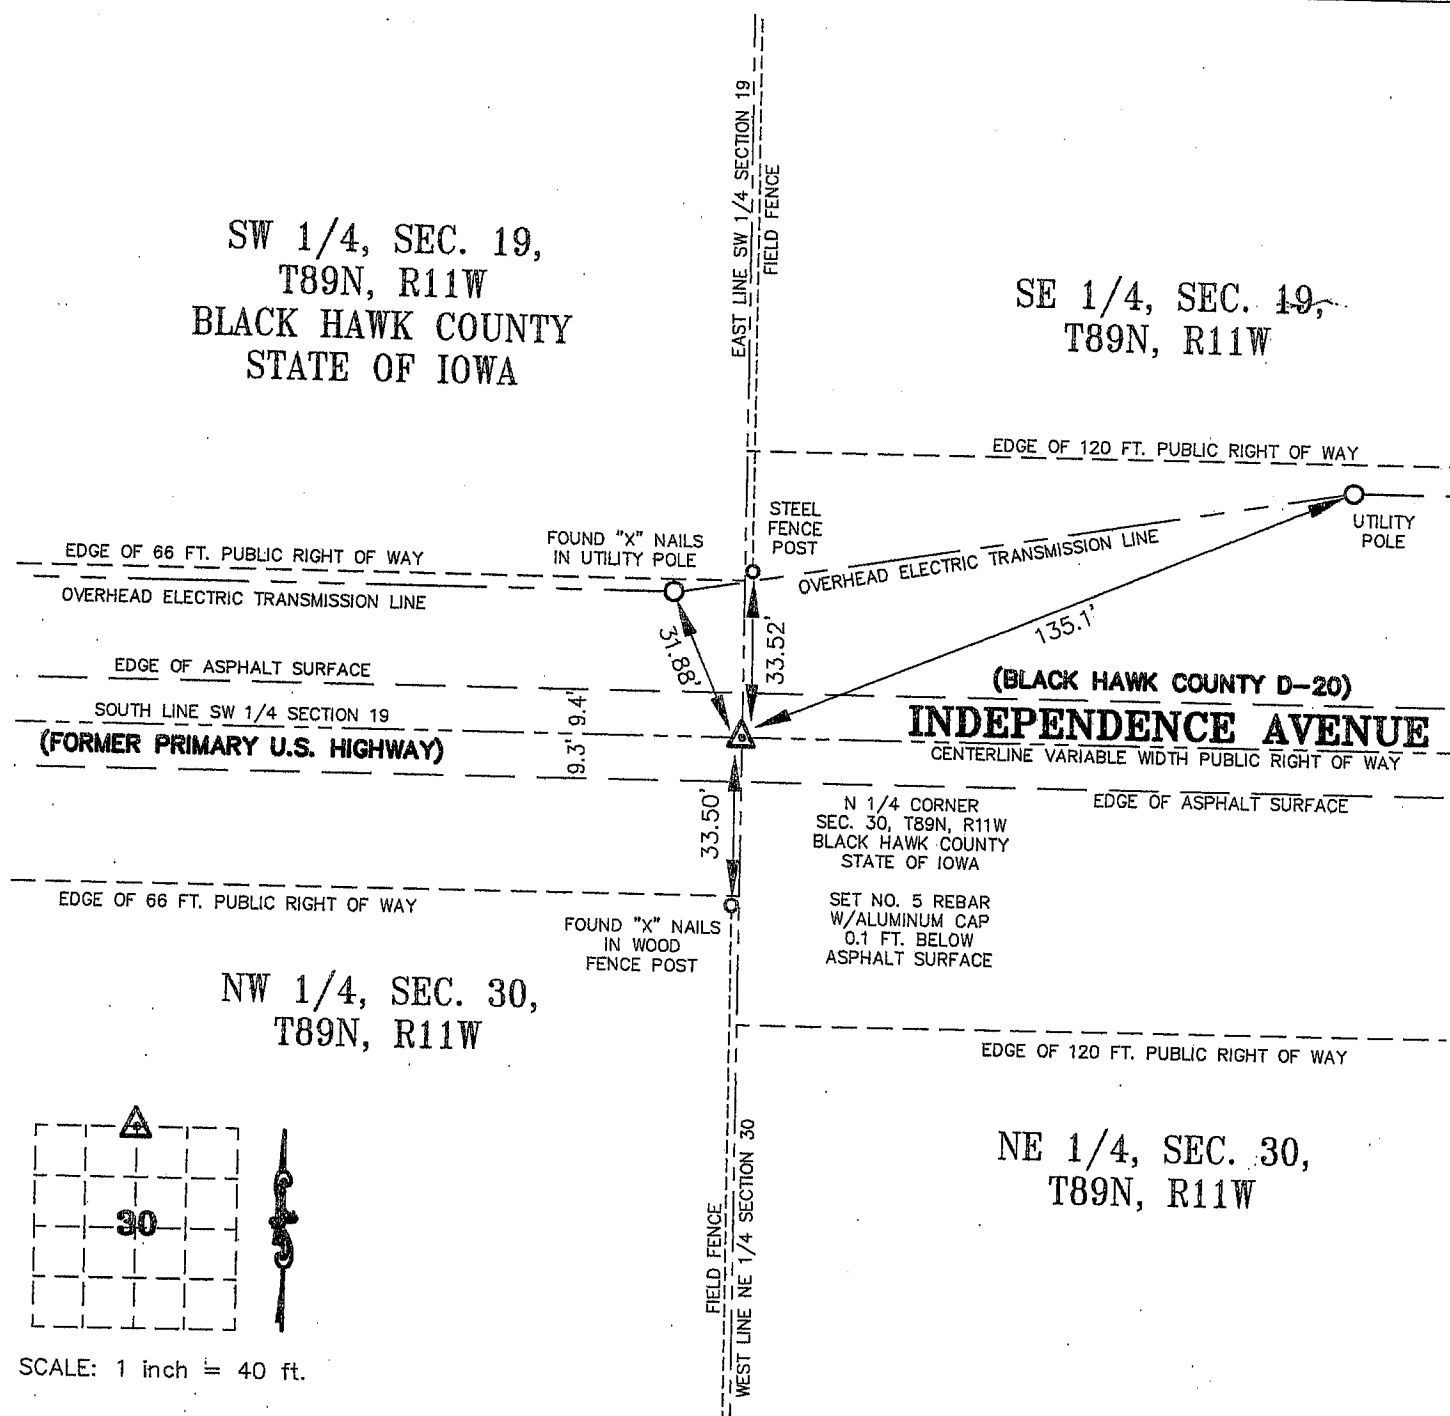

I HEREBY CERTIFY THAT THIS LAND SURVEYING DOCUMENT WAS PREPARED AND THE RELATED SURVEY WORK WAS PERFORMED BY ME OR UNDER MY DIRECT PERSONAL SUPERVISION AND THAT I AM A DULY LICENSED LAND SURVEYOR UNDER THE LAWS OF THE STATE OF IOWA.

*Kirk D. Eschliman*  
 KIRK D. ESCHLIMAN, P.L.S. IOWA LIC. NO. 9961  
 MY LICENSE RENEWAL DATE IS DECEMBER 31, 2007  
 PAGES OR SHEETS COVERED BY THIS SIGNATURE & SEAL: SHEET 1 OF 1



## LIST OF CORNERS TO BE INDEXED:

CORNER	SEC.	TWP	RANGE
N 1/4	30	T89N	R11W

**KESS & ASSOCIATES, INC.**  
 723 BROADWAY, WATERLOO, IOWA 50703-5811 PHONE: (319) 234-0509

DATE OF FIELD WORK: 03/20/2007  
 DWG. DATE: 03/26/2007  
 CADD FILE: 07A31SCC1.DWG  
 DRAWN BY: BJYK  
 PROJECT NO.: 07A31