

INDEX

BLACK HAWK COUNTY, IOWA:ss

FEE BOOK # 20 04 21615

PROOF

FILED FOR RECORD JAN 13 2004 AT 4:00 P.M. FEE 1-5.00/ - 5.00/

COMPARED

Patricia A. Jess

BLACK HAWK COUNTY RECORDER


ENV KESS & ASSOCIATES 723 BROADWAY ST WATERLOO, IA 50703

Kirk D. Eschliman, P.L.S. Iowa Lic. No. 9961, 723 Broadway Street, Waterloo, Iowa 50703 - Phone: 319-234-0509

UNITED STATES PUBLIC LAND SURVEY CORNER CERTIFICATE OF

LAND SURVEY MONUMENTS SITUATED IN SECTION 31, TOWNSHIP 89 NORTH
RANGE 11 WEST, OF THE FIFTH PRINCIPAL MERIDIAN, BLACK HAWK COUNTY, IOWA.
PREVIOUSLY RECORDED IN (NOT PREVIOUSLY RECORDED) (BOOK, PAGE, DOCUMENT NUMBER, ETC.) IN THE COUNTY RECORDER'S OFFICE.

(SHOW REASON FOR PREPARING THIS CERTIFICATE, THE EVIDENCE AND DETAILED PROCEDURES USED IN ESTABLISHING THE CORNER POSITIONS AND MONUMENTATION FOUND OR PLACED.)
MONUMENT DESCRIPTION AND REMARKS: FOUND ALUMINUM CAP ON SURFACE OF ASPHALT ROAD SURFACE.
IN CENTER OF WHITE PAINTED "X" AERIAL SURVEY TARGET. TOP OF CAP WAS UNREADABLE.

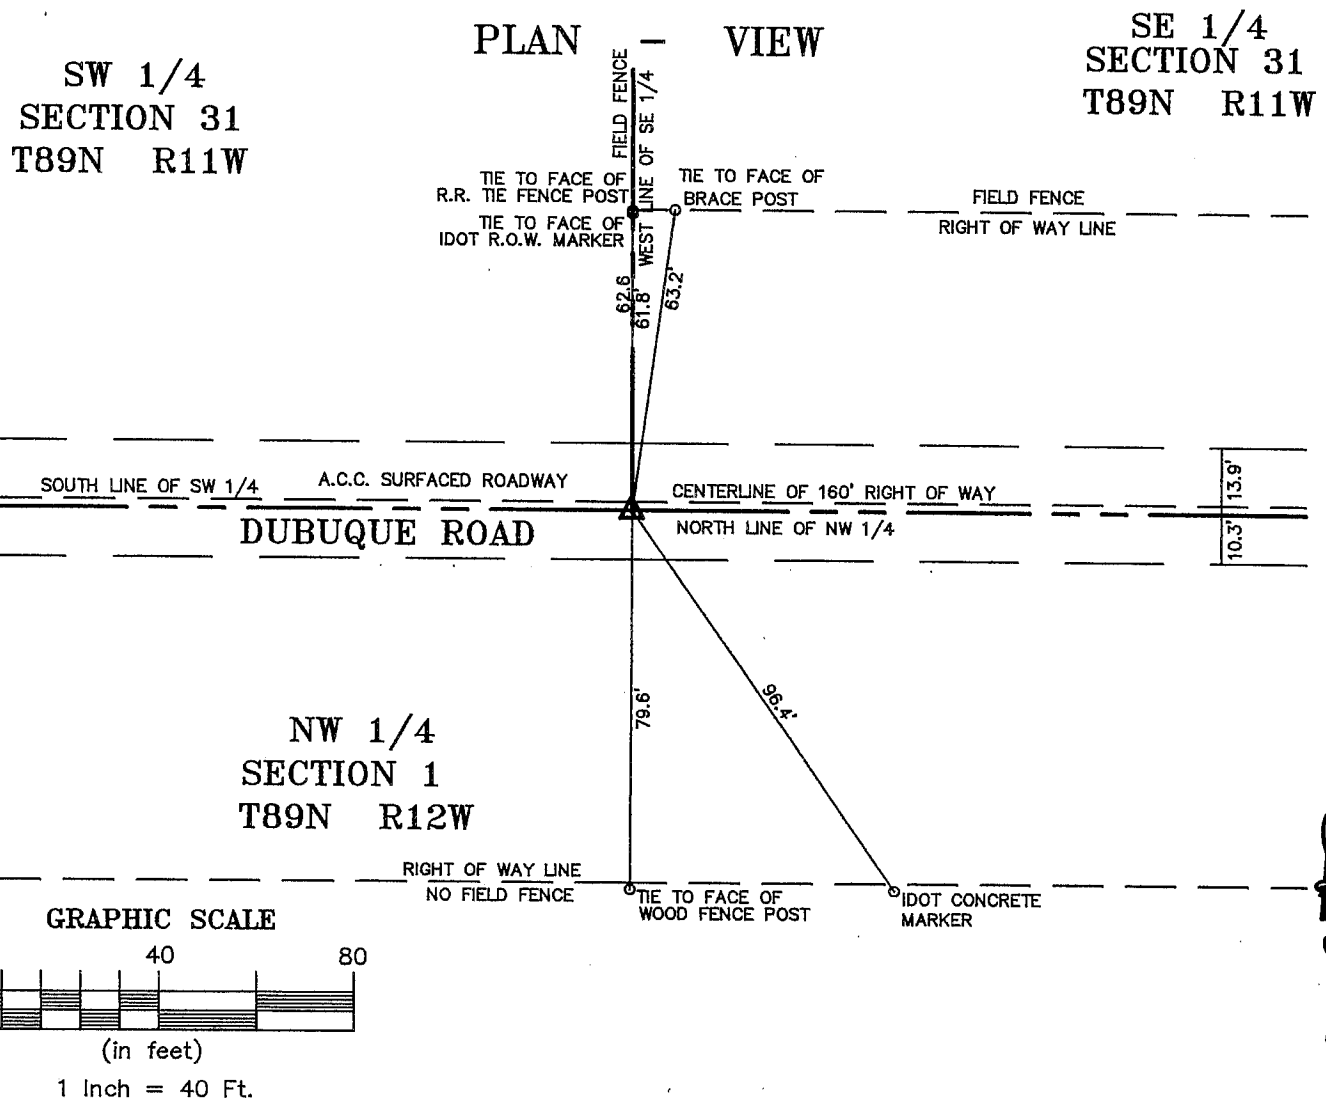

I HEREBY CERTIFY THAT THIS LAND SURVEYING DOCUMENT
WAS PREPARED AND RELATED SURVEY WORK WAS
PERFORMED BY ME OR UNDER MY DIRECT PERSONAL
SUPERVISION AND THAT I AM A DULY LICENSED LAND
SURVEYOR UNDER THE LAWS OF THE STATE OF IOWA.

Kirk D. Eschliman

DATE: 12/04/2003

KIRK D. ESCHLIMAN, P.L.S. IOWA LIC. NO. 9961
MY LICENSE RENEWAL DATE IS DECEMBER 31, 2003.
PAGES OR SHEETS COVERED BY THIS SIGNATURE & SEAL: SHEET 1 OF 1

FOR: JOE THOME & SONS TRUCKING, INC.
EAST DUBUQUE ROAD
BLACK HAWK COUNTY, IOWA

REQ. BY: RON THOME
RAYMOND, IOWA



KESS & ASSOCIATES, INC.
PROFESSIONAL LAND SURVEYORS: 723 BROADWAY, WATERLOO, IOWA 50703-5811
DATE: 12/04/03 C.A.D.D. FILE: 03B64-CS2.DWG PROJECT NO.: 03B64

List of corners to be indexed:

Corners	Section	Township	Range
S 1/4	31	T89N	R11W

SECTION 31

