



WAYNE CLAASSEN ENGINEERING AND SURVEYING, INC. P.O. BOX 898 WATERLOO, IOWA 50704-0898

PHONE: (VOICE) 319-235-6294 (FAX) 319-235-0028

## UNITED STATES PUBLIC LAND SURVEY CORNER CERTIFICATE

33 Land Survey Monuments situated in Section \_\_\_ 89 North  $_{oldsymbol{-}}$  , Township  $_{oldsymbol{-}}$ <u>11 West</u>, of the Fifth Principal Meridian, Black Hawk County, Iowa. FEE BK. 2005 - 22803 k, page, document number, etc.) Previously recorded in \_ \_ in County Recorder's Office. Monument Description and Remarks From WPA notes found in Black Hawk County Engineer's Office: "Found Iron Pipe 1 3/4" x 23" long . Lowered evidence and set C.M. on Top 12" deep." Found Standard Concrete Monument 18" deep with rebar on North side. This certificate was filed because there is no certificate on file.

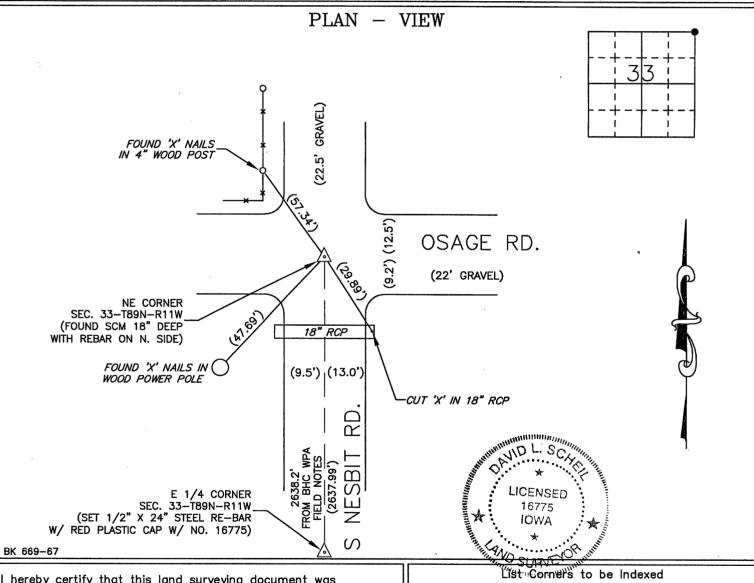

I hereby certify that this land surveying document was prepared and the related survey work was performed by me or under my direct personal supervision and that I am a duly Licensed Land Surveyor under the laws of the State of Iowa.

Signature: David L. Scheil, L.S

Date: June 19 Lic. No. 16775

Pages or Sheets Covered by this Seal: THIS SHEET ONLY.

My license renewal date is December 31, 2012

SEAL

Corners	Section	Twp	Range
NE CORNER,	33	89 N	11 W
NW CORNER,	34	89 N	11 W
SE CORNER,	28	89 N	11 W
SW CORNER,	27	89 N	11 W