003899210001 Type: GEN Doc ID: 003899210001 Type: GEN Kind: CORNER Recorded: 09/09/2009 at 01:14:40 PM Fee Amt: \$0.00 Page 1 of 1 Instr# 200900007456 k Hawk County Iowa TH A MCCARTHY RECORDER 1080 Page 79628 - 79628

File 2010-0005160

PREPARED BY:

BLACK HAWK COUNTY ENGINEERS OFFICE

316 E. FIFTH STREET, ROOM 211 WATERLOO, IOWA 50703 PH.# (319) 833-3008 FAX.# (319) 833-3139

SLSI 9-94 CERT 12-96

UNITED STATES PUBLIC LAND SURVEY CORNER CERTIFICATE OF Land Survey Monuments situated in Section______, Township___89 N Range 11 W , of the Fifth Principal Meridian, BLACK HAWK County, Iowa. Previously recorded in MISC. Book 295, Page 228, in County Recorder's Office.

(Show reason for preparing this certificate): The corner monument has been Replaced or Modified, per Ia. Code 355.11(1)(c)

(Evidence and detailed procedures used in establishing the corner position(s) and monumentation found or placed.) Monument Description and Remarks: N. 1/4 CDR. FOUND P.K. NAIL PER CURRENT RECORD PRIOR TO MILLING 2" Dp. ACC PVM'T. AND 3" Dp. HMA SURFACING. EXISTING PCC RECORD PRIOR TO MILLING 2" Dp. ACC PVM'I. AND 3" Dp. HMA SURFACING. LAISTING, CO PVM'T. NOT SEARCHED FOR MONUMENTATION, PER CURRENT RECORD REFERENCE. RECORD WPA NOTES STATE "PLUG ON C.L. PVM'T. HWY. #20 NOT FOUND" YET DENOTE RECORD MEAS. TO LAND CORNERS E-W AS SHOWN, WHILE RECORD COUNTY TIES ONLY REFER TO "PLUG IN ASHAI T" DATED AUG. 1960 WITH "NO" GEOM. TIE REF.'S OF RECORD. RESET 5" DURA TO ASHAI TO DATED AUG. 1960 WITH "NO" GEOM. EXISTING PCC SPIKE W/WASHER FLUSH WITH ACC/HMA PVM'T., AND LOCATED AT 0.6' NORTH OF NEW C.L PREV. REFERENCE TO P.K. NAIL SET 98.35' PAVING JOINT. WEST DΕ PRIOR TO RESURFACING.

NOTE: ALL DISTANCES PLUMB/HORIZ. (H.D.), "UNLESS DENOTED".

PLAN VIEW "NOT TO SCALE"


BHco Hist. Ties:


#1002 p.36-89-11


FIELD BOOK: Topcon 7i Std. Meas

(Show a minimum of three reference ties to durable physical objects, relevant monuments and physical conditions that will enable recovery of the corner.)

- TIES PER EDM MEASURE IN EITHER PRISM "OR" NON-PRISM MODE, WHILE UTILIZING "DIRECT" MEASURE.
- 2.5 SECTION LINE MEASURE REFERS TO "LOCAL GROUND" DIST. AND
 INCLUDES ELLIPSOIDAL (COMBINED) SCALE FACTOR FROM S.P.C. GRID INVERSE (AS OBSERVED, PER AVG. SCALE FACTUR = 1.0000909055624

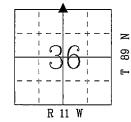

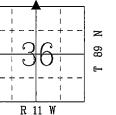

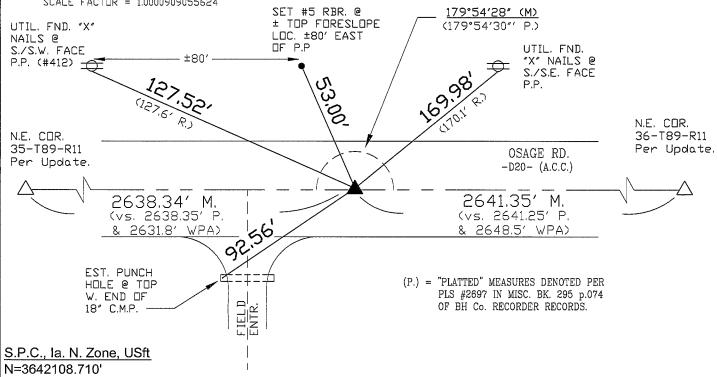

CERTIFICATION



(NAD83) "BHco1994 Net Adj.", RTK Obs.)

E=5301156.330'

I hereby certify that this land surveying document was prepared and the related survey work was performed by me or under my direct personal supervision and that I am a duly licensed Land Surveyor under the laws of the State of Iowa.

09/09/09

15748

2010 My license renewal date is December 31,_

Pages or sheets covered by this seal:

This Land Corner Certificate Only.

LIST CORNERS TO BE INDEXED

Corner	Section -	TOWNSHIP ~	Kange
N. 1/4 Cor.	36	89 N	11 W
S. 1/4 Cor.	25	B9 N	11 W

G.T./J.Z./D.B.

J.Z. & G.T.

INDEX OF ABBREVIATIONS

Dimension "Platted" Dimension
"Record" Dimension
"Calculated" Dimensi

FIELD SURVEY:

PREPARED BY:

Dimension

"NP" = Reflectoriess EDM Meas.
"MLM" = Indirect Measure
"CM" = Concrete Monument
"SM" = Survey Marker Spike/Tag

06/01/09

9/9/09

= Calculated Dimension Sm - Survey Marker Sp. = Iowa Geodetic Survey
= Works Progress Admin. Survey
per George Miller Survey (BHco Surveyor 1858-1860)
per John Ball Survey (BHco Surveyor 1866-1891)
per Nathan Barber Survey (BHco Surveyor 1908-1931)