

PREPARED BY: BLACK HAWK COUNTY ENGINEERS OFFICE
316 E. FIFTH STREET, ROOM 211 WATERLOO, IOWA 50703

PH.# (319) 833-3008
FAX.# (319) 833-3139
SLSI 9-94
CERT 12-96

UNITED STATES PUBLIC LAND SURVEY CORNER CERTIFICATE OF
Land Survey Monuments situated in Section 36, Township 89 N,
Range 11 W, of the Fifth Principal Meridian, BLACK HAWK County, Iowa.
Previously recorded in MISC Book 299, Page 535, in County Recorder's Office.

(Show reason for preparing this certificate): The corner monument has been Replaced or Modified, per Ia. Code 355.11(1)(c)

(Evidence and detailed procedures used in establishing the corner position(s) and monumentation found or placed.)

Monument Description and Remarks: N.E. COR. CURRENT CORNER RECORD REFERS
TO "FND. PK NAIL", PER RECORD PLATS OF SURVEY TO WEST. CORNER NOT RECOVERED
DURING PRELIM. PROJECT SURVEY (FALL 2006) FOR PLANNED RECONSTRUCTION PROJECT.
PLAT OF SURVEY PER MISC. BK. 266 p.415 & p.659 REFERENCED TO ASSIST. WITH RE-EST.
OF CORNER. PLAT OF SURVEY PER PLS #2697 OF MISC. BK. 295 p.074 ALSO UTILIZED
FOR REFERENCE TO RECORD ANGLE AT N.1/4 SECTION. RECORD PLS #7474 CORNERS @
R/W HELD, IN ADDITION TO W. LINE OF SAID SURVEY PER MISC. BK. 266-659. CORNER
RESET HOLDING PLATTED DIST. OF 1320.62' EAST FROM CALC. S.E. COR. SW1/4-SE1/4 (PER
PLS #7474 PLAT STATES "SET NAIL", ALSO "NOT" FND. DURING PROJECT PRELIM. SURVEY).
CORNER UPDATED DUE TO CO. RESURF. PROJECT AT INTERSECTION & WEST INTO BH. CO.
RESET 5" L. DURA™ SPIKE w/WASHER AND FLUSH WITH ACC/HMA PAVEMENT, LOCATED ±
C.L. OF NEW PAVING JOINT & ALIGNED WITH GRAVEL RD. (CO. LINE RD.) TO NORTH.

NOTE: ALL DISTANCES PLUMB/HORIZ.
(H.D.), "UNLESS DENOTED".


PLAN VIEW

BHco Hist. Ties: BK. #1002 p.36 89-11

FIELD BOOK: Topcon 7i MLM Meas.

"NOT TO SCALE"

(Show a minimum of three reference ties to durable physical objects, relevant monuments and physical conditions
that will enable recovery of the corner.)

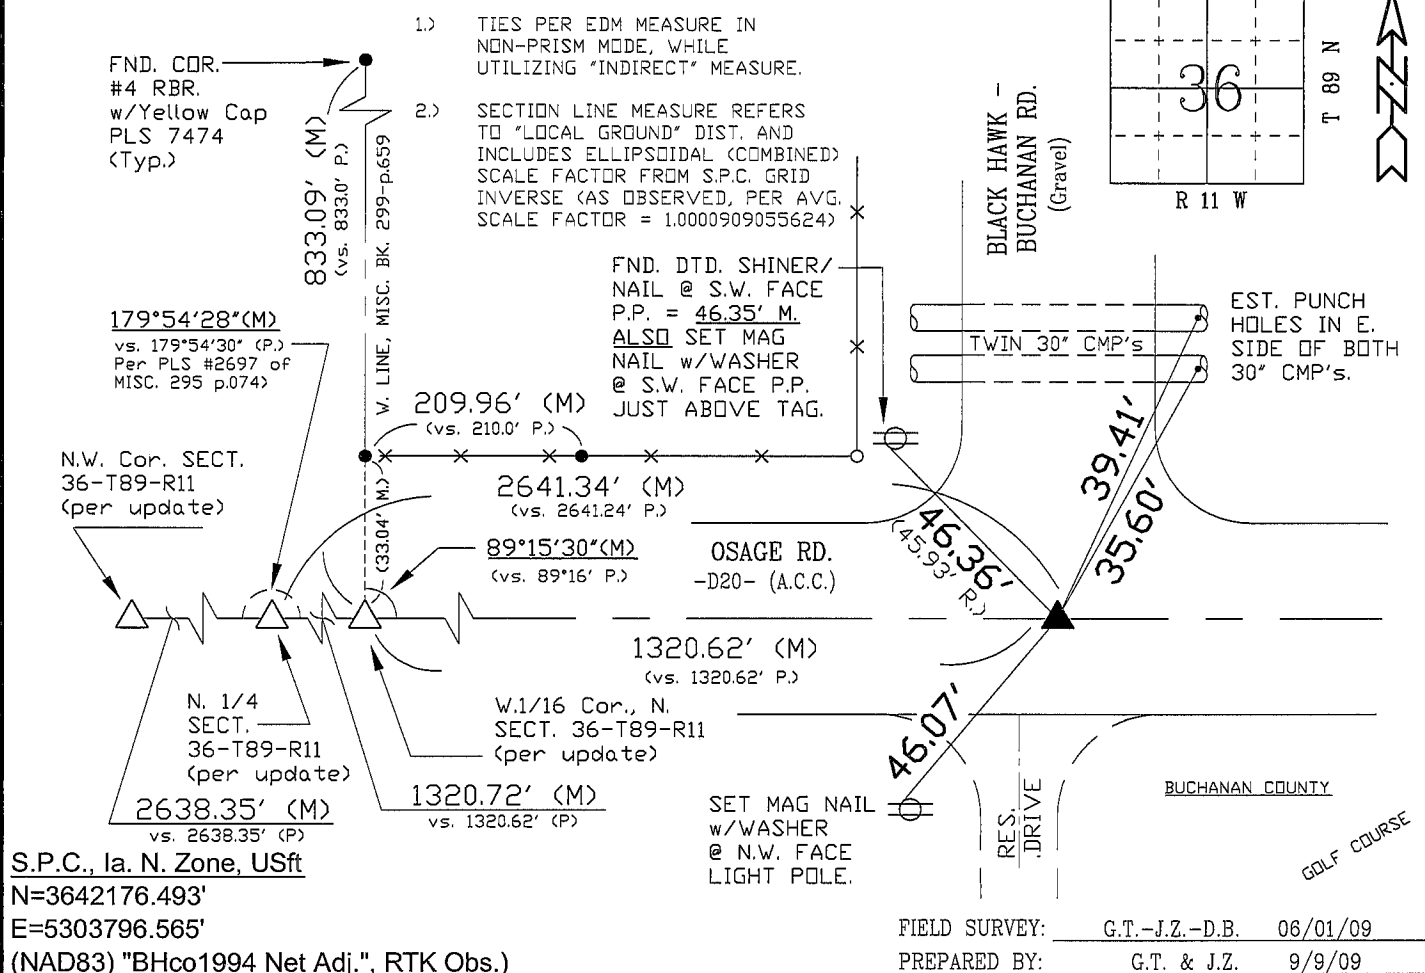

CERTIFICATION

I hereby certify that this land surveying document
was prepared and the related survey work was
performed by me or under my direct personal
supervision and that I am a duly licensed Land
Surveyor under the laws of the State of Iowa.

Geoffrey Allen Tinker 09/09/09
Geoffrey Allen Tinker (date)

License Number 15748

My license renewal date is December 31, 2010

Pages or sheets covered by this seal:

This Land Corner Certificate Only.

LIST CORNERS TO BE INDEXED

Corner	Section -	Township -	Range
N.E. Cor.	36	89 N	11 W
S.E. Cor.	25	89 N	11 W

INDEX OF ABBREVIATIONS

(M) = "Measured" Dimension
(P) = "Platted" Dimension
(R) = "Record" Dimension
(C) = "Calculated" Dimension
"IGS" = Iowa Geodetic Survey
"WPA" = Works Progress Admin. Survey
"G" = per George Miller Survey (BHco Surveyor 1858-1860)
"B" = per John Ball Survey (BHco Surveyor 1866-1891)
"N" = per Nathan Barber Survey (BHco Surveyor 1908-1931)
"NP" = Reflectorless EDM Meas.
"MLM" = Indirect Measure
"CM" = Concrete Monument
"SM" = Survey Marker Spike/Tag

