Doc ID: 009495480001 Type: GEN Recorded: 02/28/2019 at 10:42:52 AM Fee Amt: \$0.00 Page 1 of 1 Black Hawk County Iowa SANDIE L. SMITH RECORDER

File 2019-00013020

Prepared by & Return to: Herold - Reicks Surveying, 2206 East Bremer Avenue, Waverly, IA 50677, Ph. 319-483-5187

## **United States Public Land Survey Corner Certificate**

Land Survey Monument situated in

Section 9, Township 89 North, Range 12 West of the Fifth Principal Meridian, Black Hawk County, Iowa. On file in **Document #2008009409** in the County Recorder's office.

This certificate is being prepared in compliance with Iowa Code Chapter 355.11 because:




- There is no certificate on file for this corner.
- There are no longer three valid ties of record.
- There are changes to reference ties of record.
- There is change of monumentation of record.
  - To clarify description of record monument (ties).

## **Monument Description and Remarks:**

East 1/4 Corner: The previously recorded Section Corner Certificate, indicates Found 5/8"Ø Rebar with Aluminum Cap "Black Hawk County Land Corner", said monument was removed during highway reconstruction. The position of said Section Corner was reestablished with information obtained from previously recorded Section Corner Certificate. Set 1"Ø Bronze Survey Marker PLS 22468 at said position to perpetuate the Corner. Corner reset in conjunction with Project No. FM-C007(149)--55-07.

## Plan View

(Show a minimum of three reference ties to durable physical objects, relevant monuments and physical conditions that will enable recovery of the corner.)

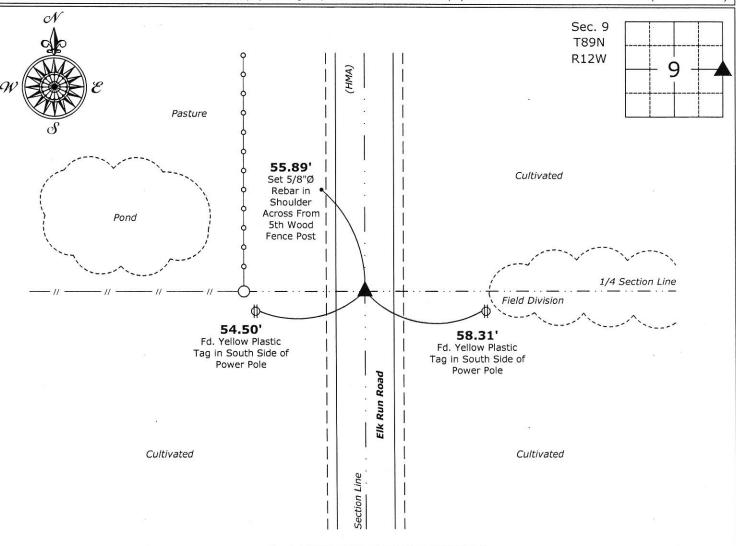

East 1/4 Corner of Section 16-89-12 Set 1"Ø Bronze Survey Marker PLS 22468



I hereby certify that this land surveying document was prepared and the related survey work was performed by me or under my direct personal supervision and that I am a duly licensed Land Surveyor under the laws of the State of Iowa.

Sauch M. Isaiah M. Reicks

2-25-19

Date:

License number 22468 My license renewal date is December 31, 2019. Sheets covered by this seal: Individual sheet only

ii.	
Project Number: 2018-853	
FB: Black Hawk 10, Pgs. 35	

Twp.

89

Range

12

List Corner to be Indexed

Section

9

Corner

E 1/4