

SC ✓  
MISC ✓  
INDEX ✓  
MARGIN ✓  
PROOF ✓  
COMPARE ✓

BLACK HAWK COUNTY IOWA:SS 4307  
Filed for record AUG 21, 1998, at  
11:00 A.M. and recorded in Book 331  
of MISC Page 231.  
*Patricia A. Jess* Recorder  
Fee 1-5.00/  
HAROLD MICHELS  
410 BRENTWOOD AVE  
WATERLOO IA 50701

Harold F. Michels 410 Brentwood Ave., Waterloo, Iowa 50701 319-235-7770

## UNITED STATES PUBLIC LAND SURVEY CORNER CERTIFICATE

Land Survey Monuments situated in Section 11, Township 89 North, Range 12 West, of the Fifth Principal Meridian, BLACK HAWK County, Iowa.  
Previously recorded in (NONE) in County Recorder's Office.  
(book, page, document number, etc.)


(Show reason for preparing this certificate, the evidence and detailed procedures used in establishing the corner positions and monumentation found or placed.)

Monument Description and Remarks EXISTING CORNERS WERE FOUND AS PER  
COUNTY ENGINEERS RECORDS, AND WERE RETIED. CORNERS  
NOT FOUND WERE SET BY BREAKING DOWN THE SECTION.  
NEW TIES WERE MADE.


### PLAN - VIEW

(Show a minimum of three reference ties to durable physical objects, relevant monuments and physical conditions that will enable recovery of the corner.)


NW COR. NW 1/4

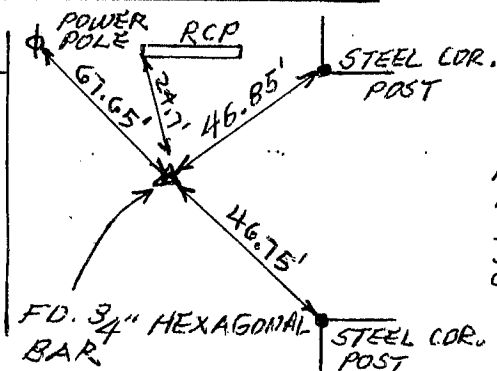


W 1/4 CORNER

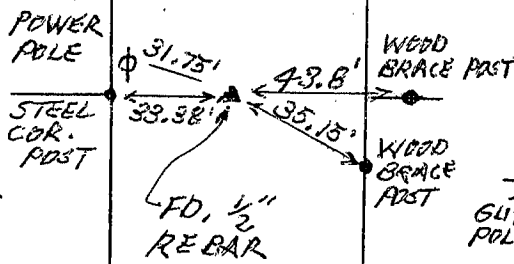


NE COR. NE 1/4

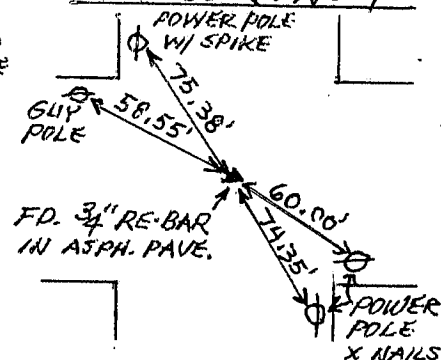



E 1/4 CORNER

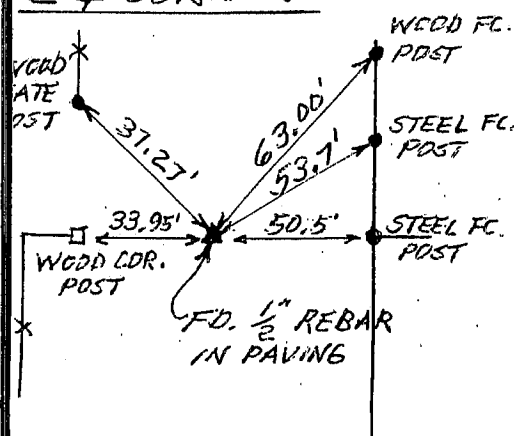

NE COR. SW 1/4 NE 1/4

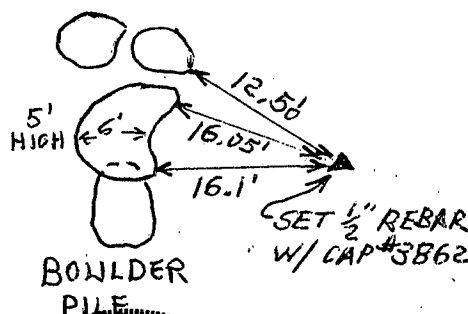

SE COR. SW 1/4 NE 1/4

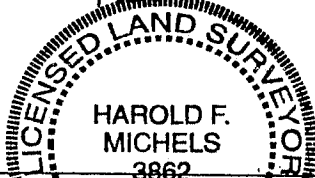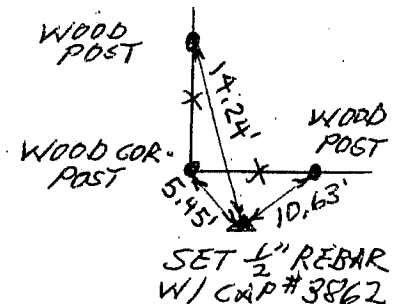

I hereby certify that the survey work was completed and this certificate was prepared by me or under my direct personal supervision and that I am a duly registered and sworn surveyor under the laws of the state of Iowa.

Signature: *Harold F. Michels*

Date: 8-11-98 Harold F. Michels Reg. No. 3862

My registration renewal date is Dec. 31, 99.

SEAL

### List Corners to be Indexed

| Corners          | Section | Twp | Range |
|------------------|---------|-----|-------|
| NW NW 1/4        | 11      | 89  | 12    |
| E 1/4            | 11      | 89  | 12    |
| W 1/4            | 11      | 89  | 12    |
| NE NE 1/4        | 11      | 89  | 12    |
| NE SW 1/4 NE 1/4 | 11      | 89  | 12    |
| SE SW 1/4 NE 1/4 | 11      | 89  | 12    |