

IRS  
P  
Z

Document Number: 2007010879  
Date: Nov 13, 2006 2:36:52 pm  
Aud Fee: 0.00 Rec Fee: 0.00  
Trans Tax: 0.00 Rec Management Fee: 0.00  
E-Com Fee: 0.00 Non-Standard Page Fee: 0.00  
Filed for record in Black Hawk County, Iowa  
Patricia S. Sass, County Recorder

PREPARED BY: BLACK HAWK COUNTY ENGINEERS OFFICE  
316 E. FIFTH STREET, ROOM 211 WATERLOO, IOWA 50703  
PH.# (319) 833-3008 SLSI 9-94  
FAX.# (319) 833-3139 CERT 12-98

UNITED STATES PUBLIC LAND SURVEY CORNER CERTIFICATE OF  
Land Survey Monuments situated in Section 13, Township 89 N,  
Range 12 W, of the Fifth Principal Meridian, BLACK HAWK County, Iowa.  
Previously recorded in Misc. Book N/A, Page N/A, in County Recorder's Office.  
(Show reason for preparing this certificate, the evidence and detailed procedures used in establishing the corner  
positions and monumentation found or placed.)

Monument Description and Remarks: FOUND #4 RBR. WITH TOP BENT.  
TEMP. TIED & EXCAVATED 2'x2'x1.5' AROUND EXIST. RBR., FND. NOTHING MORE.  
REBAR PLUMB & SOLID @ ±4" DEEP. CUT TOP 5" OFF FND. #4 RBR., AND  
BACKFILLED TO 5-1/2" DEEP w/ EXIST. GRANULAR RD. SURFACE.  
CORNER ALIGNED w/ FENCE NORTH (±), AND ±3' WEST OF FENCE SOUTH.  
COR. UPDATED FOR SECT. LINE DEF., PROP. BR. RECONSTRUCT PROJ. WEST.

PLAN - VIEW


(Show a minimum of three reference ties to durable physical objects, relevant monuments and physical conditions  
that will enable recovery of the corner.)

NOTES:


NOT TO SCALE

TIE DISTANCES PLUMB

WASHER = DENOTES STL. 2" DIA. STAMPED  
"B.H. COUNTY LAND CORNER REF."

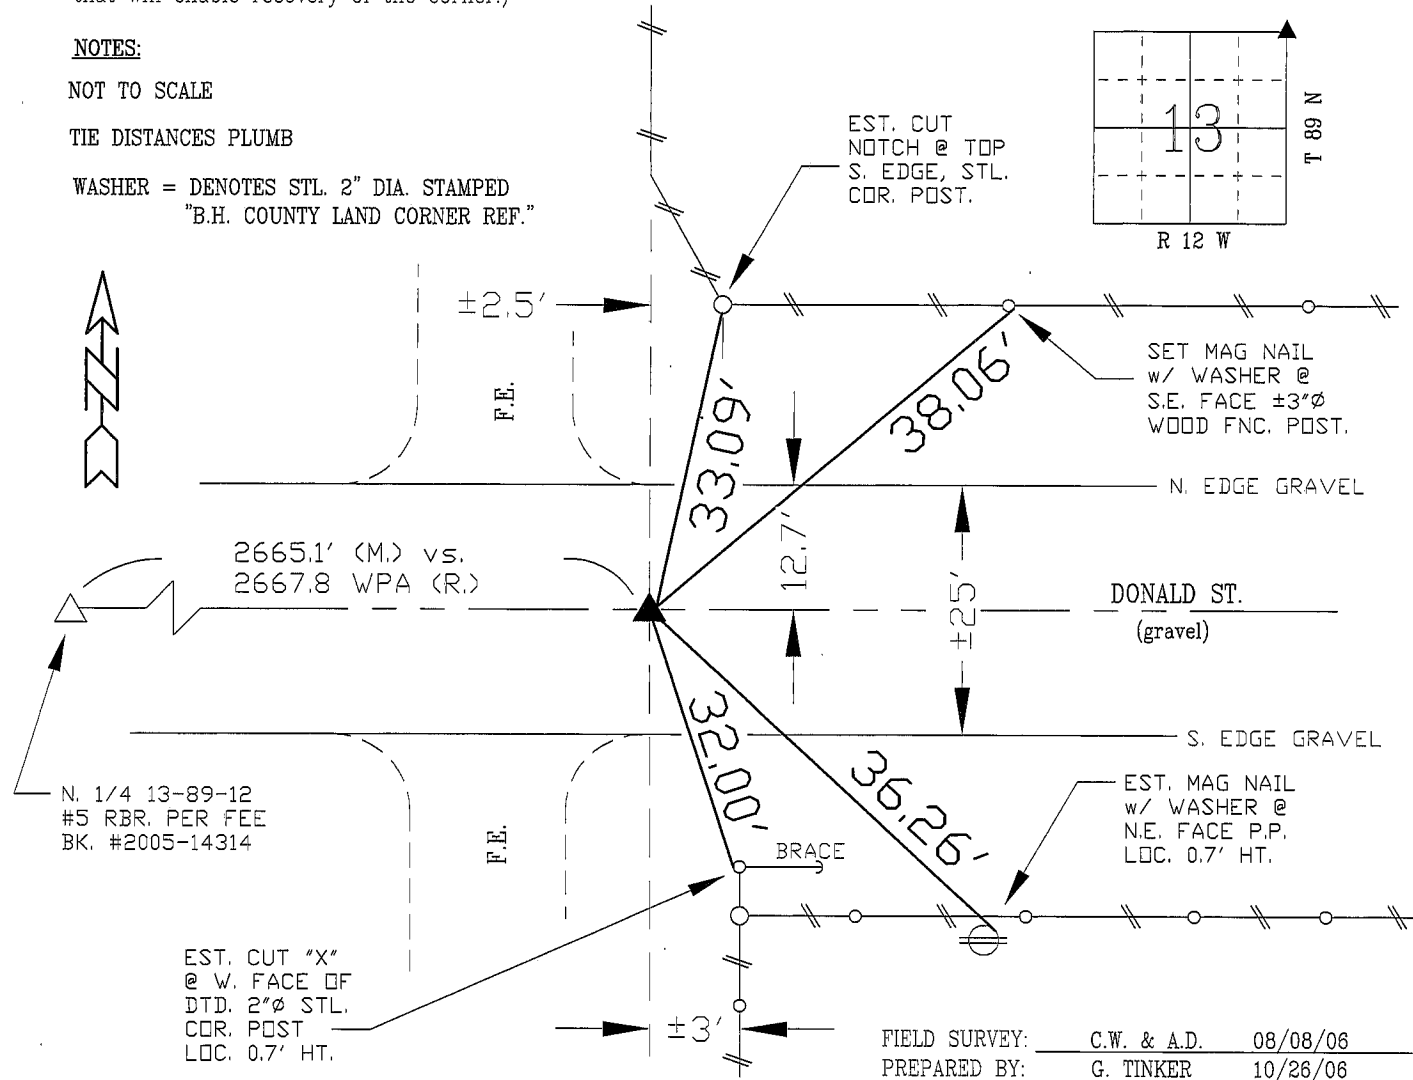

CERTIFICATION

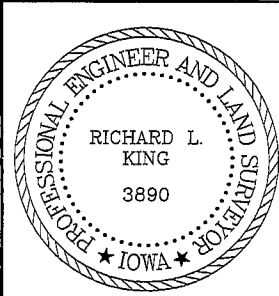

I hereby certify that this land surveying document was prepared and the related survey work was performed by me or under my direct personal supervision and that I am a duly licensed Land Surveyor under the laws of the State of Iowa.  
Richard L. King (date) 11/09/06  
License Number 3890  
My license renewal date is December 31, 2007  
Pages or sheets covered by this seal:  
This Land Corner Certificate Only.

LIST CORNERS TO BE INDEXED

Corner	Section	Township	Range
N.E. COR.	13	89 N	12 W
N.W. COR.	18	89 N	11 W
S.E. COR.	12	89 N	12 W
S.W. COR.	7	89 N	11 W