

I RS
P
Z

Document Number: 2007001466
Date: Jul 19, 2006 2:24:04 pm
Aud Fee: 0.00 Rec Fee: 0.00
Trans Tax: 0.00 Rec Management Fee: 0.00
E-Com Fee: 0.00 Non-Standard Page Fee: 0.00
Filed for record in Black Hawk County, Iowa
Patricia S. Sass, County Recorder

PREPARED BY: BLACK HAWK COUNTY ENGINEERS OFFICE PH.# (319) 833-3008 SLSI 9-94
316 E. FIFTH STREET, ROOM 211 WATERLOO, IOWA 50703 FAX.# (319) 833-3139 CERT 12-96

UNITED STATES PUBLIC LAND SURVEY CORNER CERTIFICATE OF
Land Survey Monuments situated in Section 14, Township 89, Range 12, of the Fifth Principal Meridian, BLACK HAWK County, Iowa.
Previously recorded in Misc. Book 337, Page 669, in County Recorder's Office.

(Show reason for preparing this certificate, the evidence and detailed procedures used in establishing the corner positions and monumentation found or placed.)


Monument Description and Remarks: FND. #5 RBR. PRIOR TO RESURF. PROJECT, AND TIED AS SHOWN. CORNER PREV. RE-SET AS FND. BY BH CO. IN SUMMER 2000 FOR RCP INSTALLATION @ INTERSECTION. RECORD TIES PER PLS #9961 CERT. DESTROYED PER SUMMER 2000 COUNTY SHOULDERING PROJECT. 2" HMA RESURF. AT LOCATION & EXC. 2" TO TOP #5 RBR., TOP BENT SOUTHERLY, TRUED BEST ±. HELD TIES & SET 5" L. "DURANAIL" w/ RED + HEAD & 2" ALUM. WASHER LOCATED 0.60' WEST OF C.L. ACC JOINT, AND ALIGNED (±) WITH DONALD ST. EAST/WEST.

PLAN - VIEW

(Show a minimum of three reference ties to durable physical objects, relevant monuments and physical conditions that will enable recovery of the corner.)


NOTE:

TIE DIST MEAS. PLUMB (H.D.)

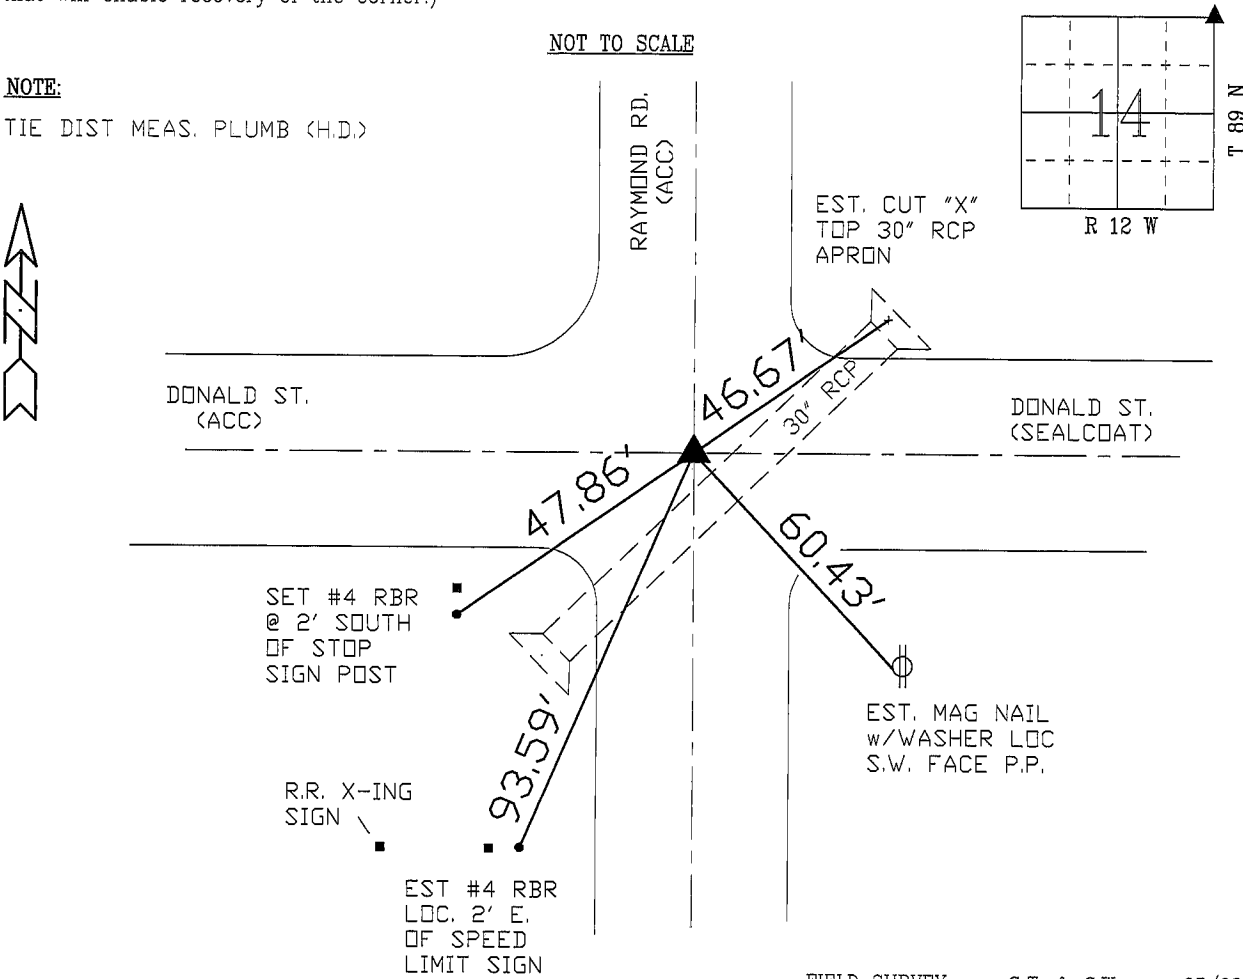

FIELD SURVEY: G.T. & C.W. 05/08/06
PREPARED BY: A.A. & G.T. 7/15/06

CERTIFICATION

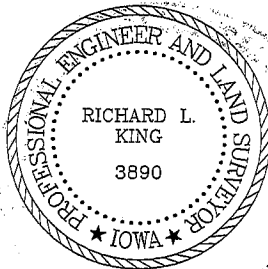

I hereby certify that this land surveying document was prepared and the related survey work was performed by me or under my direct personal supervision and that I am a duly licensed Land Surveyor under the laws of the State of Iowa.
Richard L. King 7/17/06 (date)
License Number 3890
My license renewal date is December 31, 2007
Pages or sheets covered by this seal:
This Land Corner Certificate Only.

LIST CORNERS TO BE INDEXED

Corner	Section	Township	Range
N.E. COR.	14	89	12
S.E. COR	11	89	12
N.W. COR	13	89	12
S.W. COR.	12	89	12